


T. 1S. R. 40E. W. M.

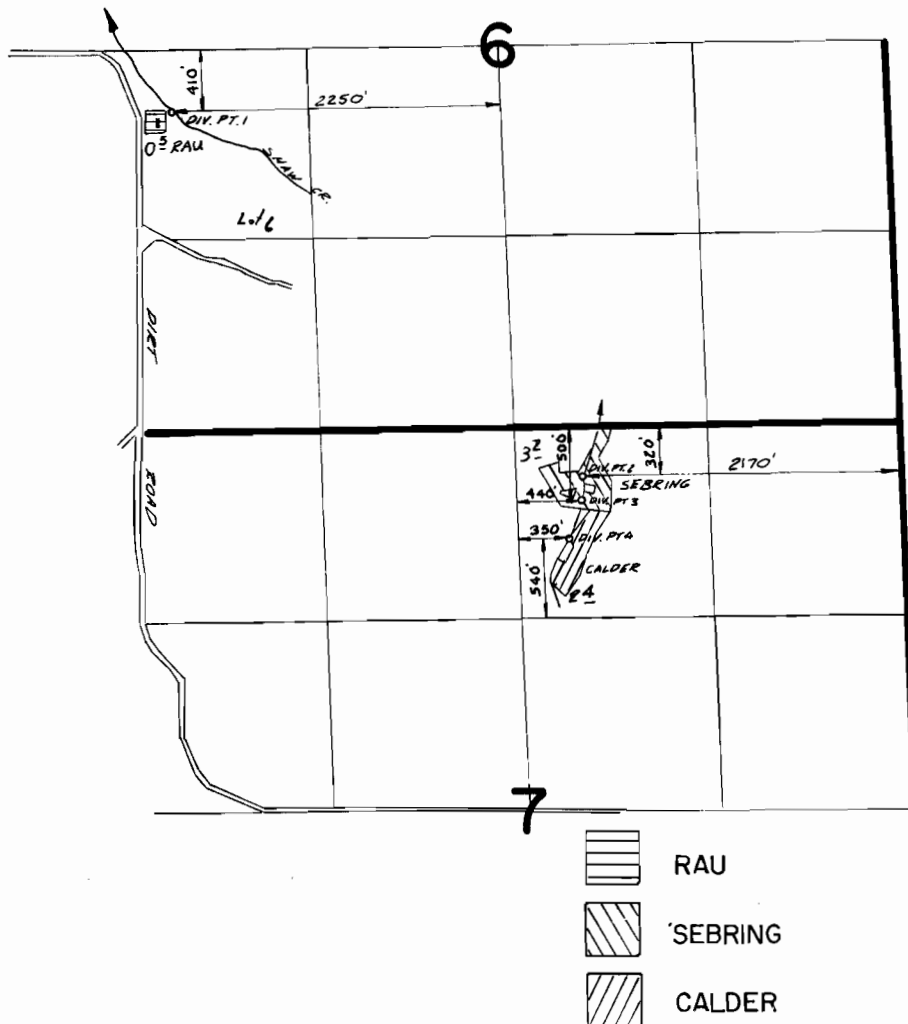

FINAL PROOF SURVEY
UNDER

Application No. 42864... Permit No. 32036...
IN NAME OF

J. & S. SEBRING ETAL

Surveyed 8-28 1979, by V. CHURCH & D. JARRETT