


T. 15. R. 48E. W. M.

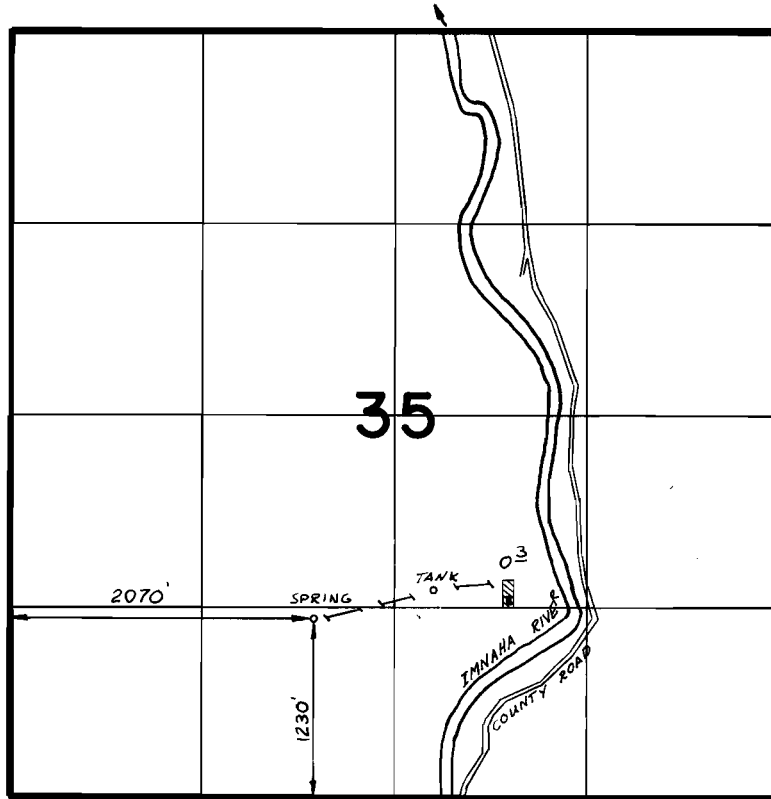

FINAL PROOF SURVEY
UNDER

Application No. 48061 Permit No. 36039
IN NAME OF

Western Industrial Maintenance Inc.

Surveyed 8-31 1978, by R. BARWIN