


# T. IS. R. 3W. W.M.

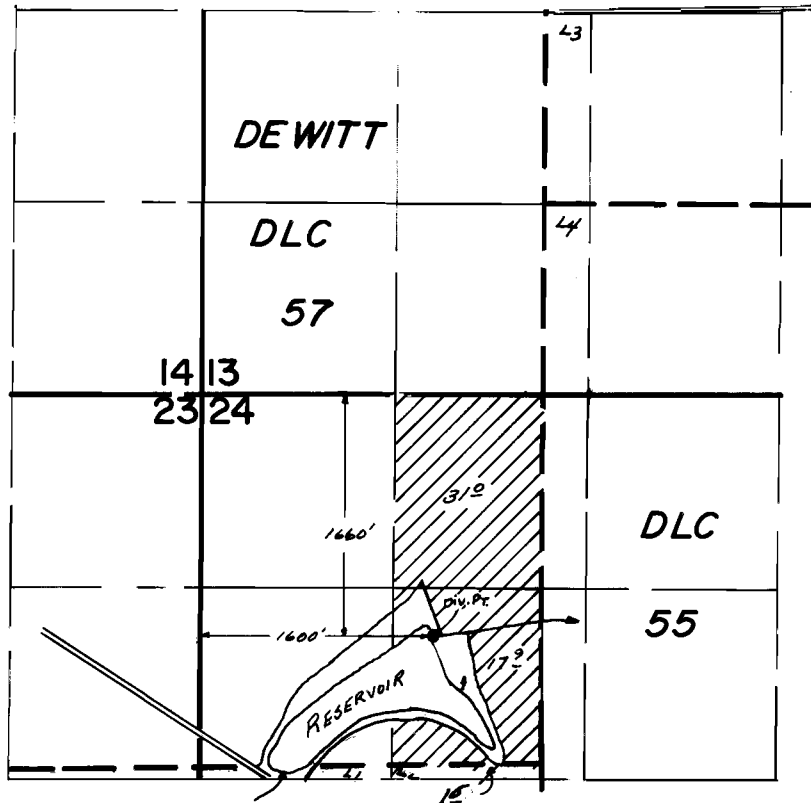

## FINAL PROOF SURVEY UNDER

R-47780                      R-5780  
Application No. 47781      Permit No. 35802  
IN NAME OF

SCHULMERICH INVESTMENTS CORP.

Surveyed MAY 4 1977, by D.M. NORBY.....