T. IS. R. 3W. W.M.

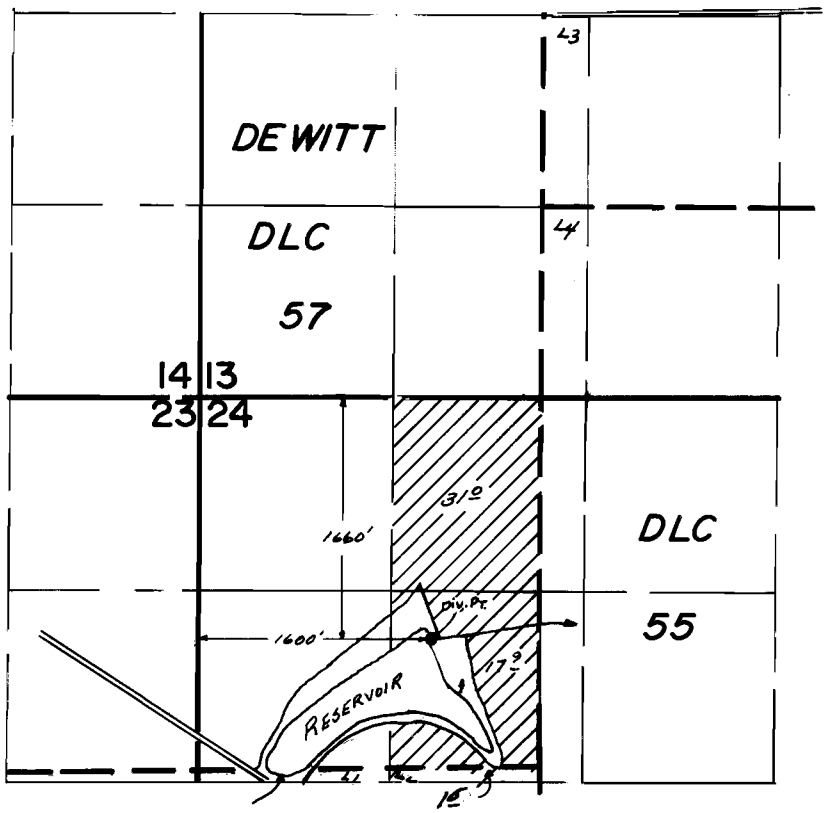

FINAL PROOF SURVEY
UNDER

Application No. R-47780 47781 Permit No. R-5780 35802
IN NAME OF

SCHULMERICH INVESTMENTS CORP.

Surveyed MAY 4 1977, by D.M.NORBY

DBS-4LL-28