


T. 5S., R. 4&5W., W.M.

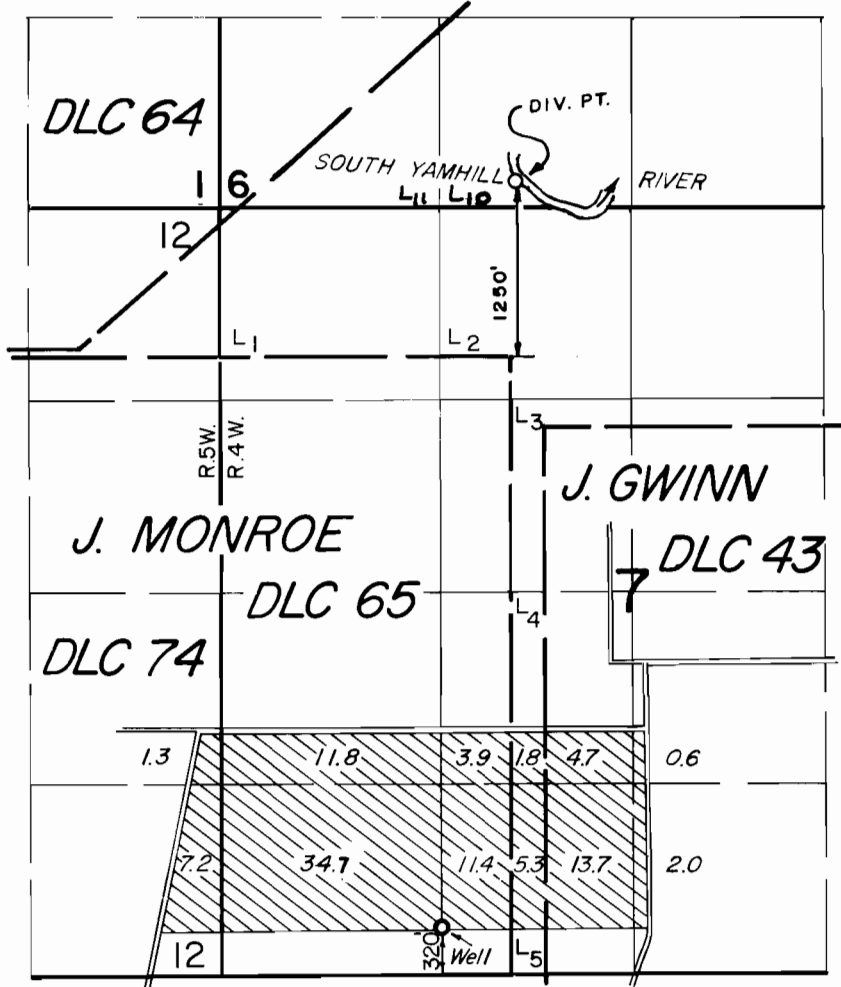

FINAL PROOF SURVEY UNDER

Application No. 51039 G-6585 Permit No. 38520 G-5828...

IN NAME OF

SHARER

Surveyed MAY 31, 1979, by *[Signature]*