


T.5S.R.3W.W.M.

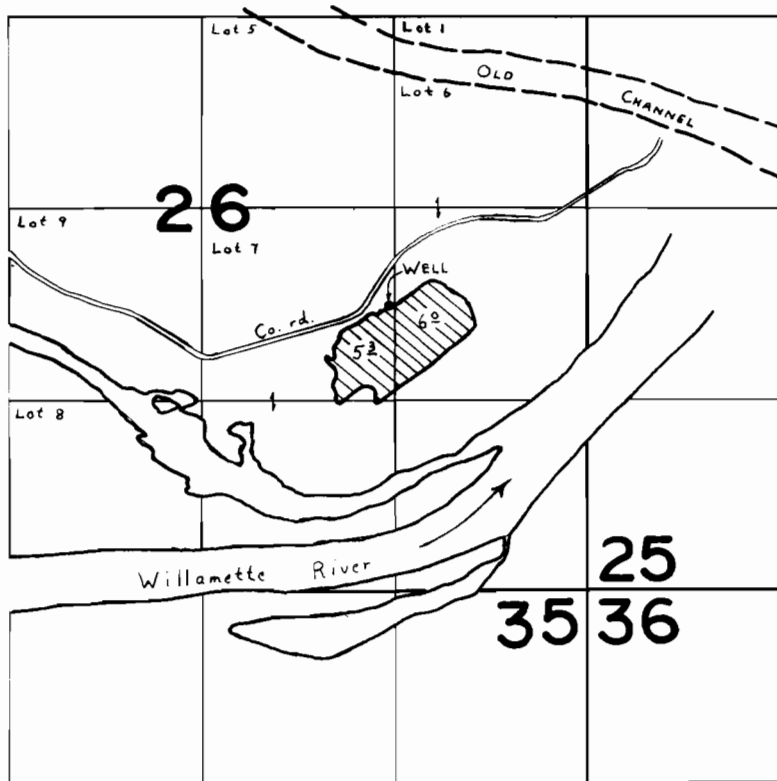

WELL LOCATED: 60'S. ; 40'W. from NE Cor. Lot 7.

FINAL PROOF SURVEY UNDER

Application No. G-7815 Permit No. G-7228
IN NAME OF

ARNOLD E. HILDEBRANDT

Surveyed SEPT. 8 1978, by C. L. HUGHES