


# T. 128&13S. R. 48&5W. W.M.

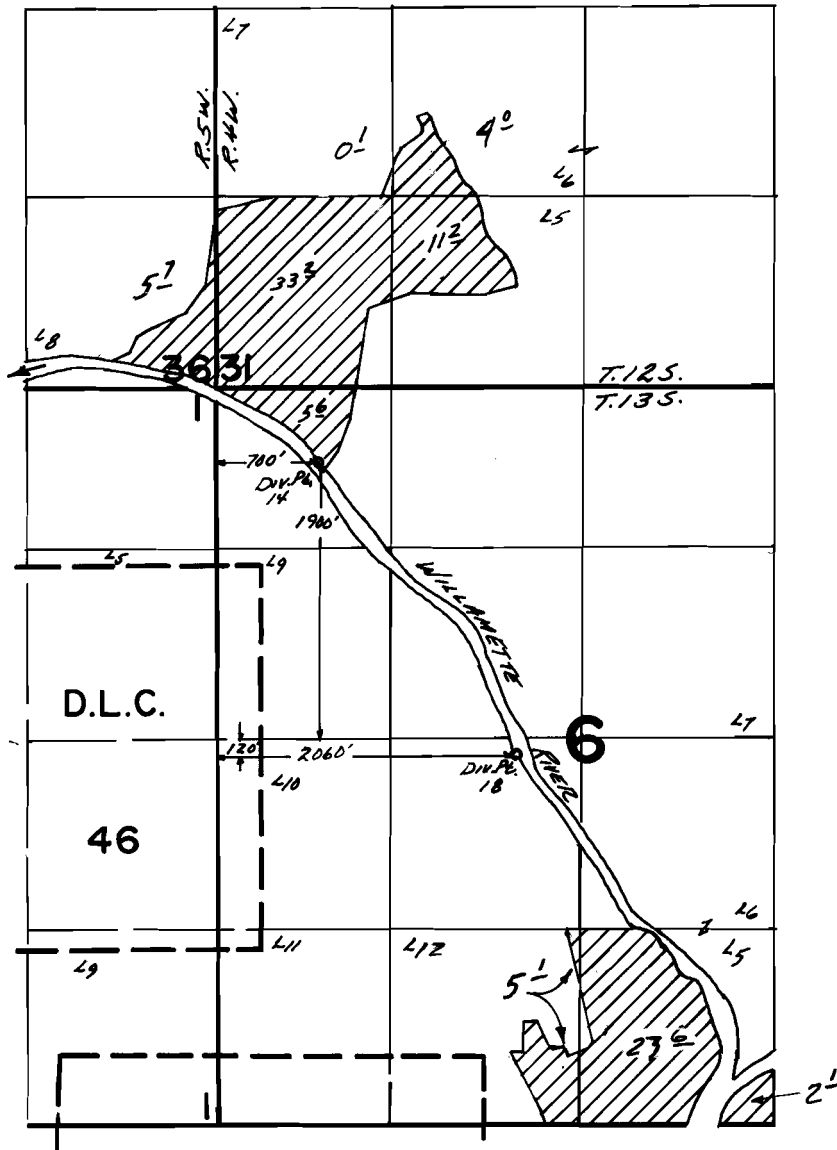

## FINAL PROOF SURVEY UNDER

Application No. 552.47... Permit No. 41623....  
IN NAME OF

.....LOREN J. SMITH.....

Surveyed March 24 1978., by J.S. Donaldson..