


T. 35S., R. 2&3W., W.M.

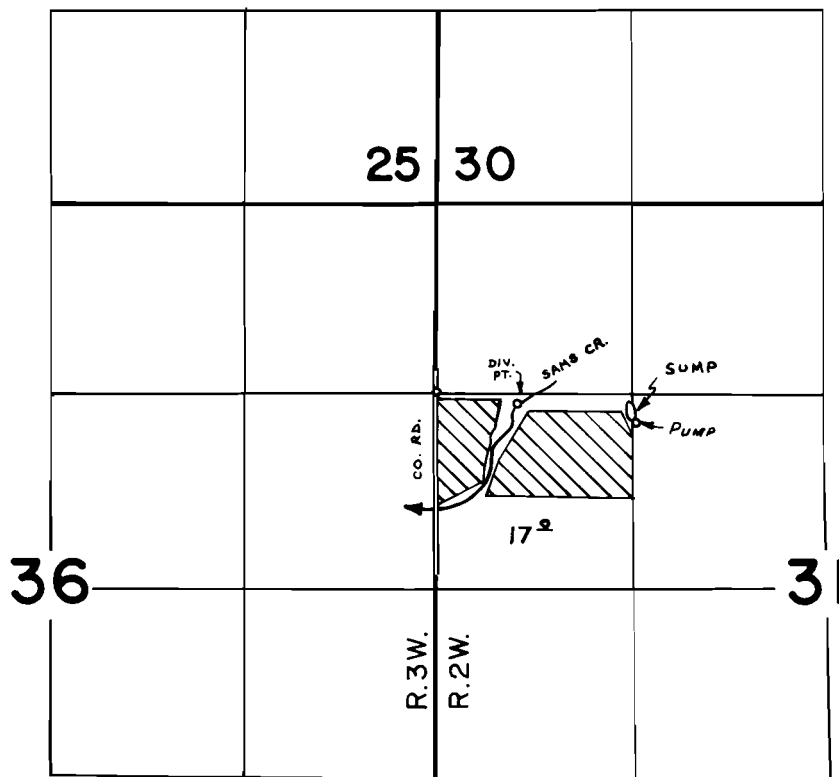

DIV. PT. LOC.: CREEK-1380'S. & 560'E.; SUMP-1430'S. & 1340'E., BOTH
FROM NW COR. SEC. 31.

FINAL PROOF SURVEY
UNDER

G-5396

G-5322

Application No. 47846 Permit No. 35860
IN NAME OF

JOSEPH P. & ANNE SMALLEY

Surveyed MAY 23 1978, by B. SUND

D.H.M.

P.T.S. - 1978-14-A