


T.36S., R.5W., W.M.

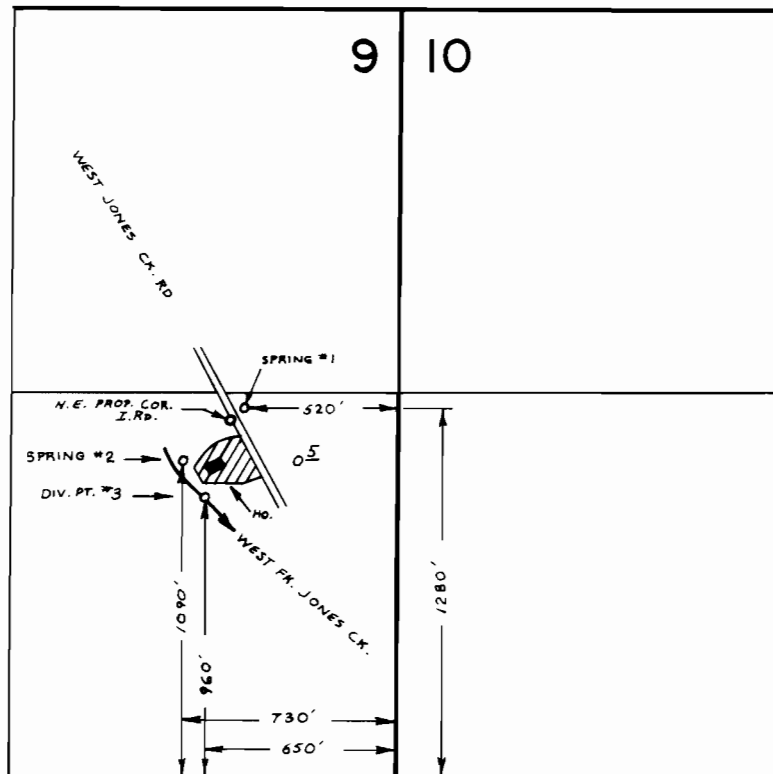

SCALE : 1" = 660 FT.

FINAL PROOF SURVEY
UNDER

Application No. 48633 Permit No. 36479
IN NAME OF

.....*Don A. & Louise Arganbright*.....

Surveyed JUL. 31 1978, by B. SUND