

Form A1-187
March 1961

UNITED STATES
DEPARTMENT OF THE INTERIOR
BUREAU OF LAND MANAGEMENT

R 7048
51077

SECTION


31
NE 1/4 NE 1/4

Oregon State Water Filings

TOWNSHIP 35S, RANGE 24E, W. M.

Final proof

North Tied in with aerial photo and OSHO Quad map.

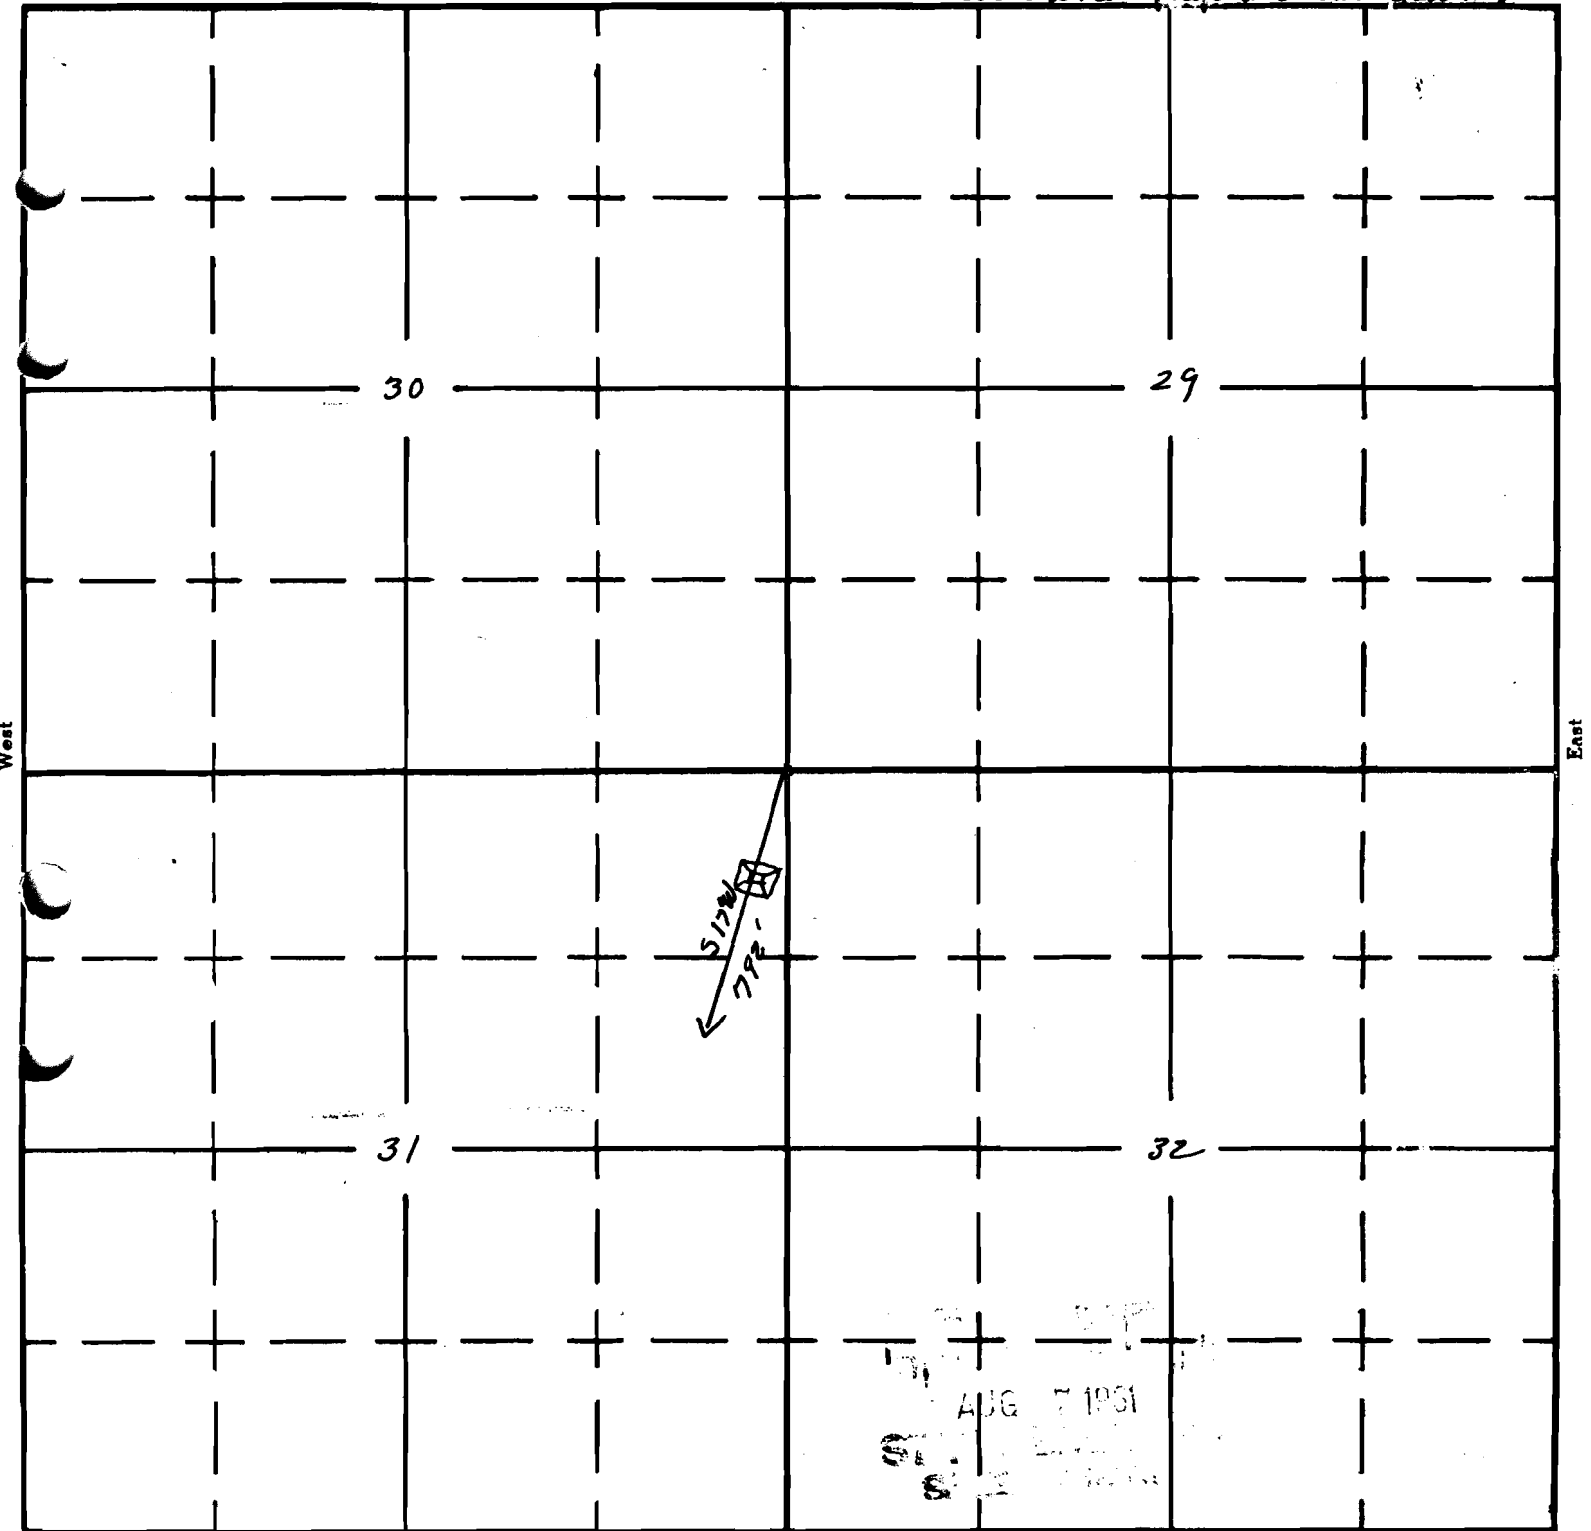

AUG 7 1961

APPLICATION No. R-36192
PERMIT No. R 7048