


T.13S.,R.10W.,W.M.

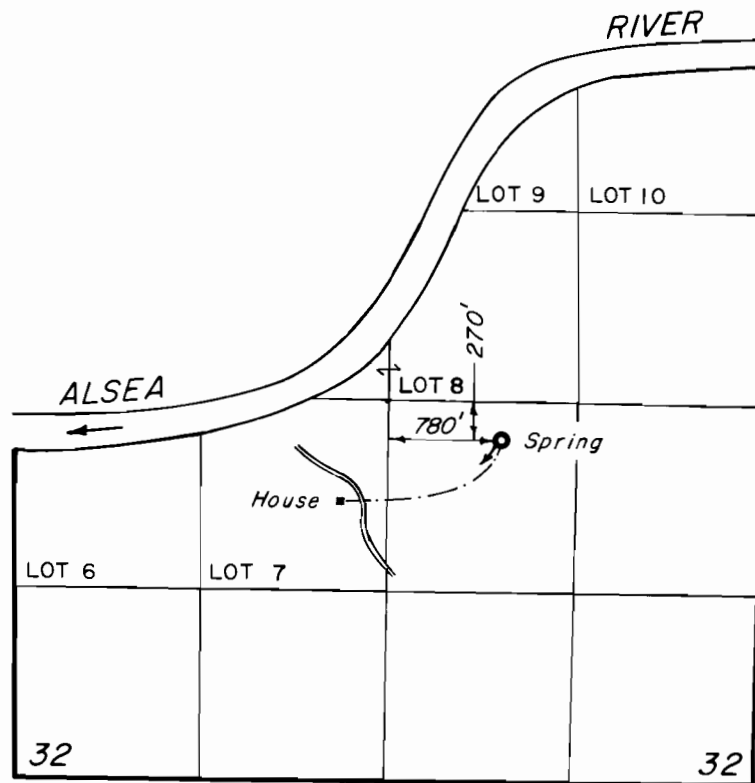

FINAL PROOF SURVEY
UNDER

Application No. 51975... Permit No. 39089...

IN NAME OF

LYNN H. COLE

Surveyed Sept. 28., 1979., by *dl Brown*