T.8S. R.2W., W.M.

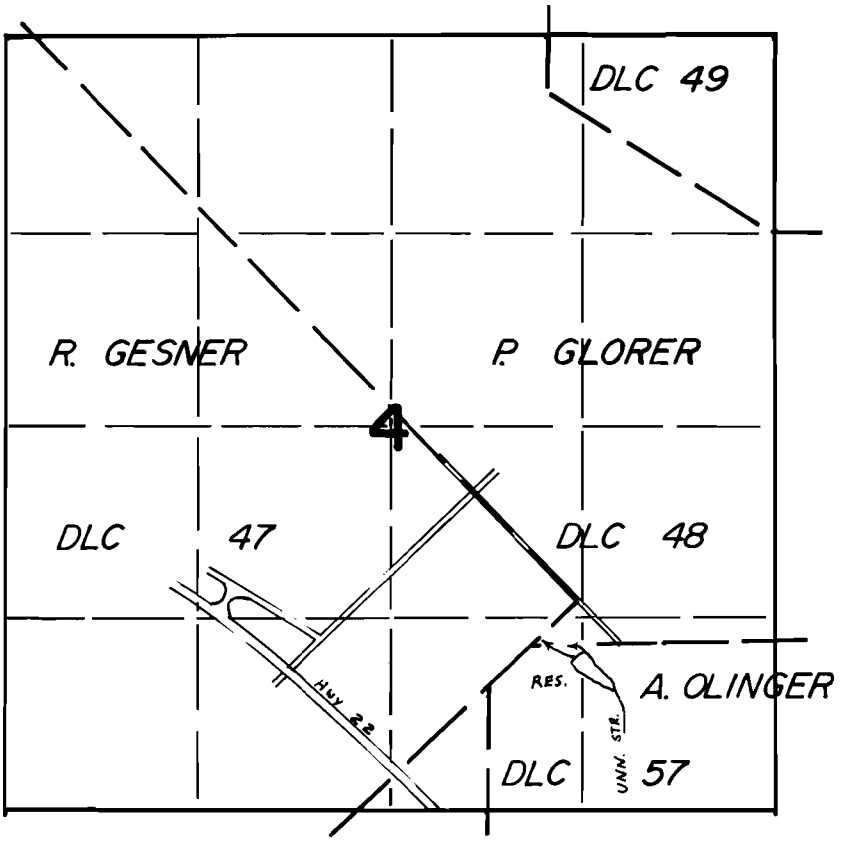

DIV. AT. LOC. 280' S. FROM MOST E'ly COR. GESNER DLC 47

FINAL PROOF SURVEY
UNDER

R-56296 R-6634
Application No. 56297 Permit No. 41963
IN NAME OF

LESLIE C. SWINK

Surveyed OCT. 19. 1978., by S.P. APPLEGATE

DPN-6LL-217