


# T.9S.R.2E., W.M.

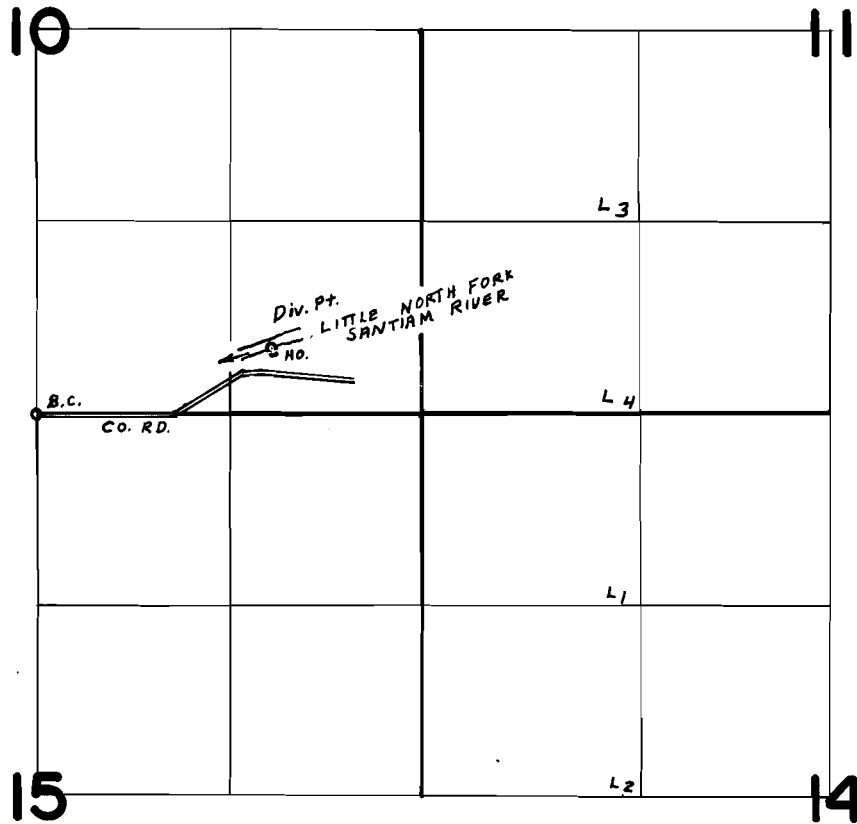

Div. Pt. Loc. 460' N. & 1040' W. From S.E. Cor Sec. 10

## FINAL PROOF SURVEY UNDER

Application No. 55962.... Permit No. 41934....  
IN NAME OF

.....Beck-Humphries.....

Surveyed MAY..22. 1978., by S.P. APPLGATE