


T.5S.,R.IW.,W.M.

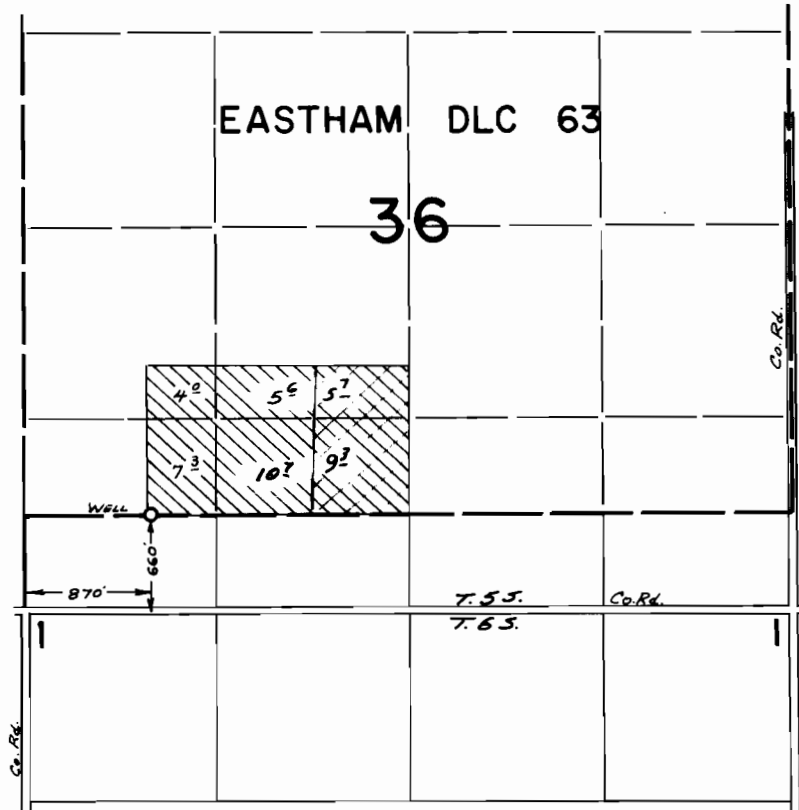

FINAL PROOF SURVEY
UNDER

Application No. G-7250 Permit No. G-6706
IN NAME OF

WALTER DUDA

Surveyed June 7, 1979, by L. H. NUNN