


T.3S.R.10W.W.M.

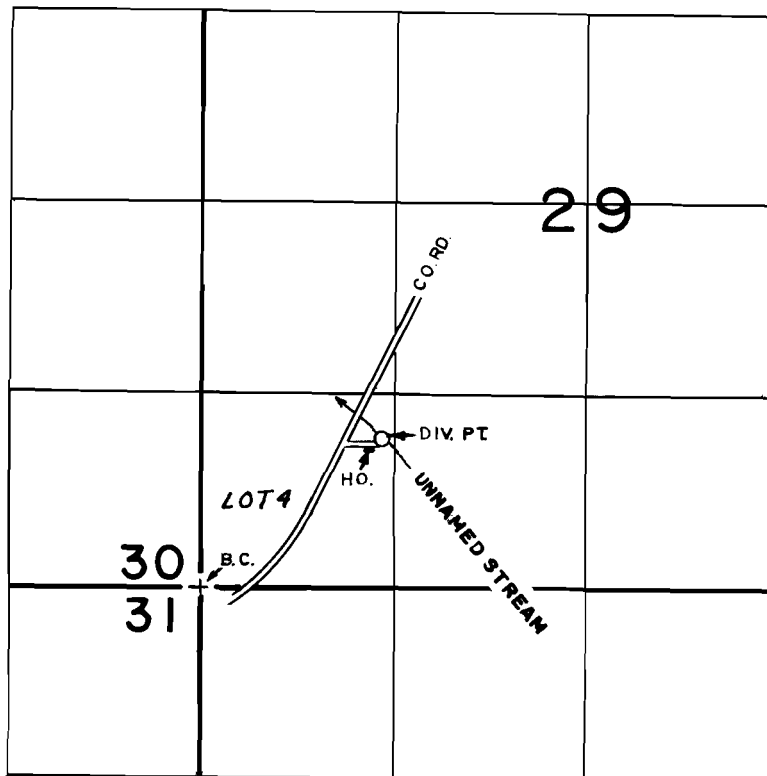

DIV. PT. LOC. 1020'N. & 1250'E. FROM S.W. COR. SEC. 29

FINAL PROOF SURVEY UNDER

Application No. 54521... Permit No. 40890....
IN NAME OF

JAMES NICK & TERESA H. DUSIC

Surveyed JAN. 25. 1980., by R.G. MUCKEN.....