


# T. 1S. R. 33E. W.M.

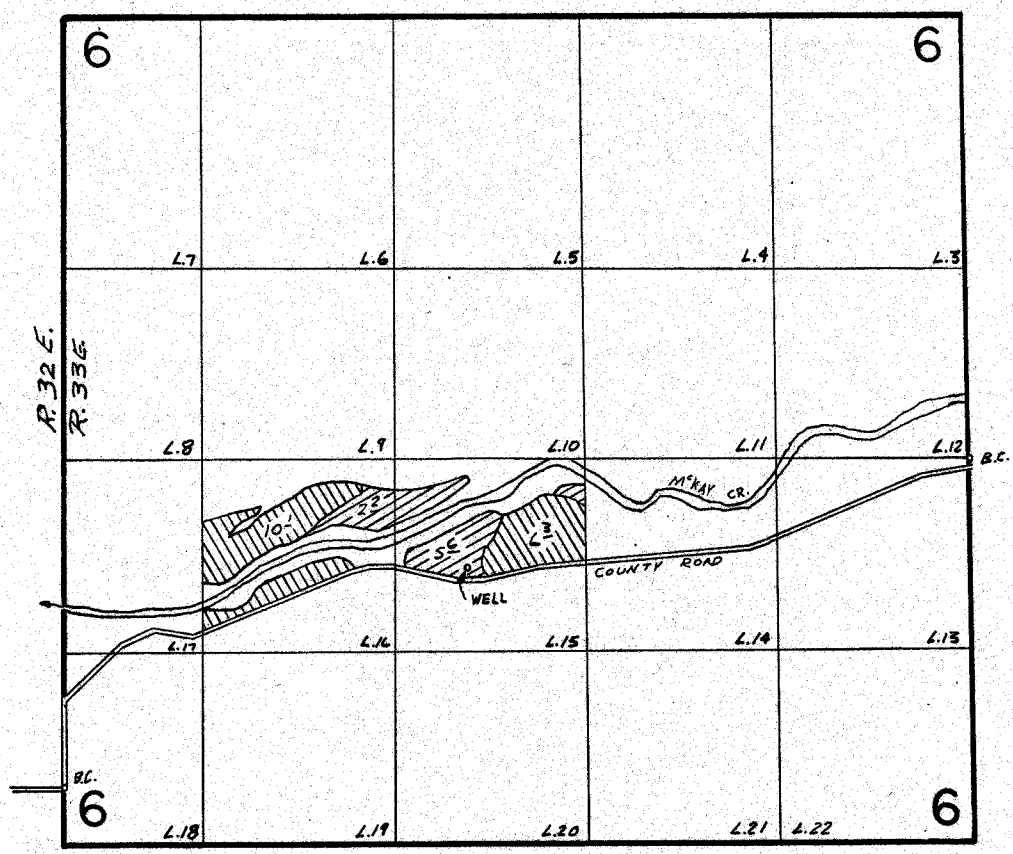

WELL LOC. 1900'N & 3410'W FROM SE COR. SEC. 6



PRIMARY



SUPPLEMENTAL

## FINAL PROOF SURVEY UNDER

Application No. G-5616... Permit No. G-5250...  
IN NAME OF

**RICHARD V. STANHOPE**

Surveyed 3-30 1978, by R. BARWIN