


T. 3 S., R. 45 E., W.M.

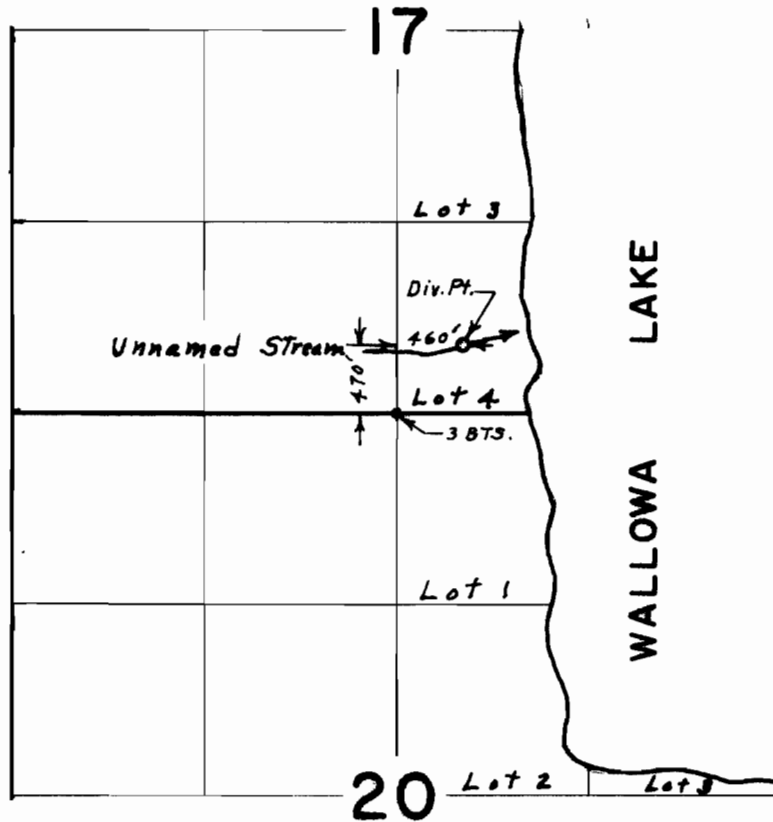

FINAL PROOF SURVEY
UNDER

Application No. 43118 Permit No. 32218
IN NAME OF

Lake Share Water Development Coop.

Surveyed June 20, 1972, by L. E. Gould