




T.2S.R.2W.W.M.

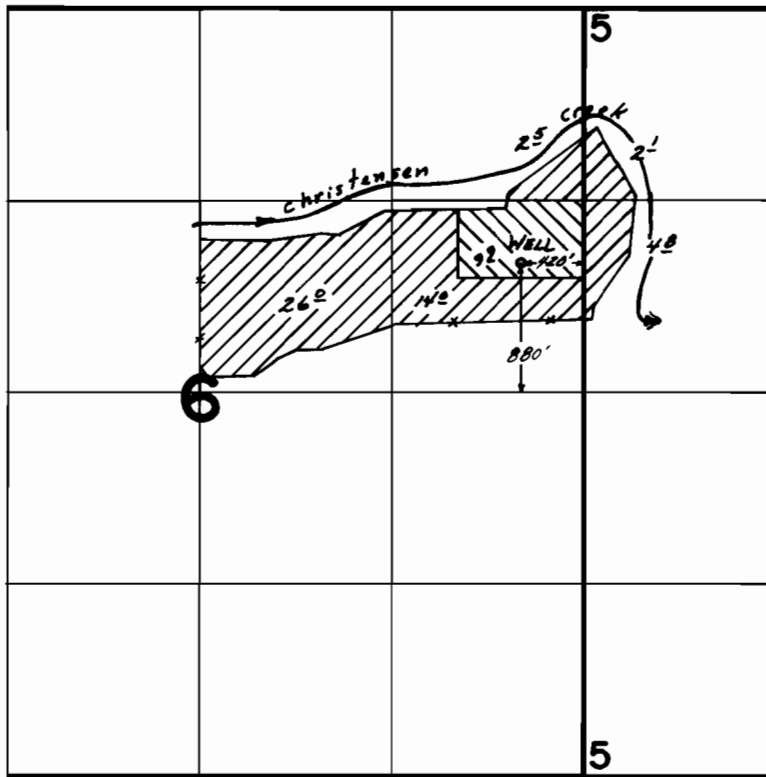

 - PRIMARY
 - SUPPLEMENTAL

FINAL PROOF SURVEY
UNDER

Application No. G-6308. Permit No. G-5929.
IN NAME OF

ALBERT & MARY ANN PETERKORT

Surveyed July 27, 1978, by R.G. Mucken.....