


T.5S. R.4W. W.M.

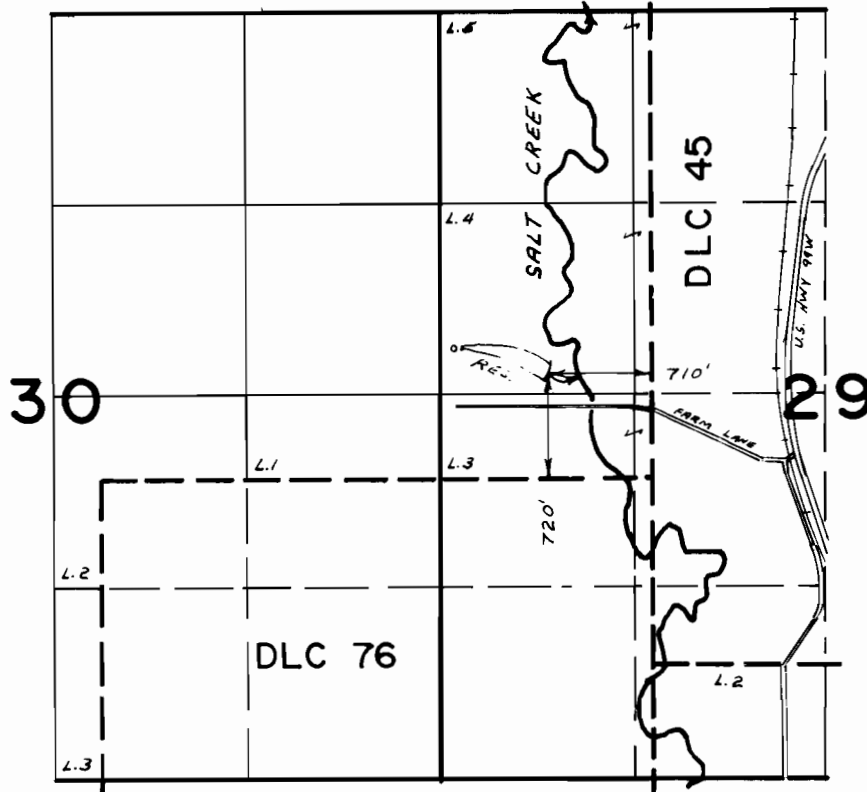

**FINAL PROOF SURVEY**  
UNDER

R-53648 R-6428  
Application No. 53649 Permit No. 40333  
IN NAME OF

ROY FREEMAN II

Surveyed MAR. 14 1978, by L.H. NUNN