


T.5S. R.4W. W.M.

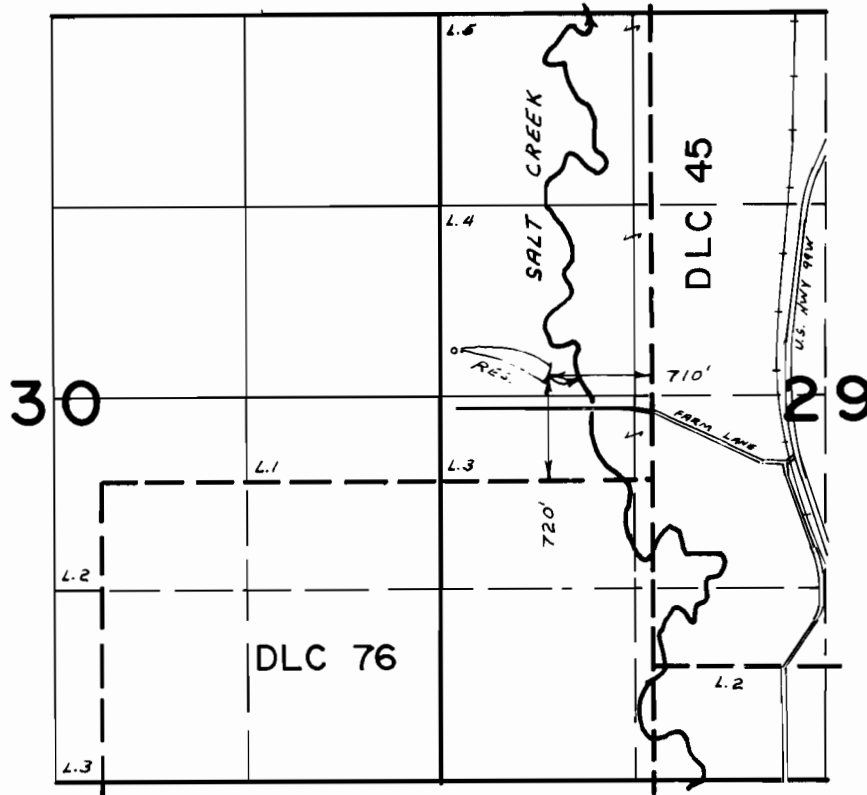

FINAL PROOF SURVEY
UNDER

R-53648 R-6428
Application No. 53649 Permit No. 40333
IN NAME OF

ROY FREEMAN II

Surveyed MAR. 14. 1978., by L.H. NUNN