


T.18S.R.40E.W.M.

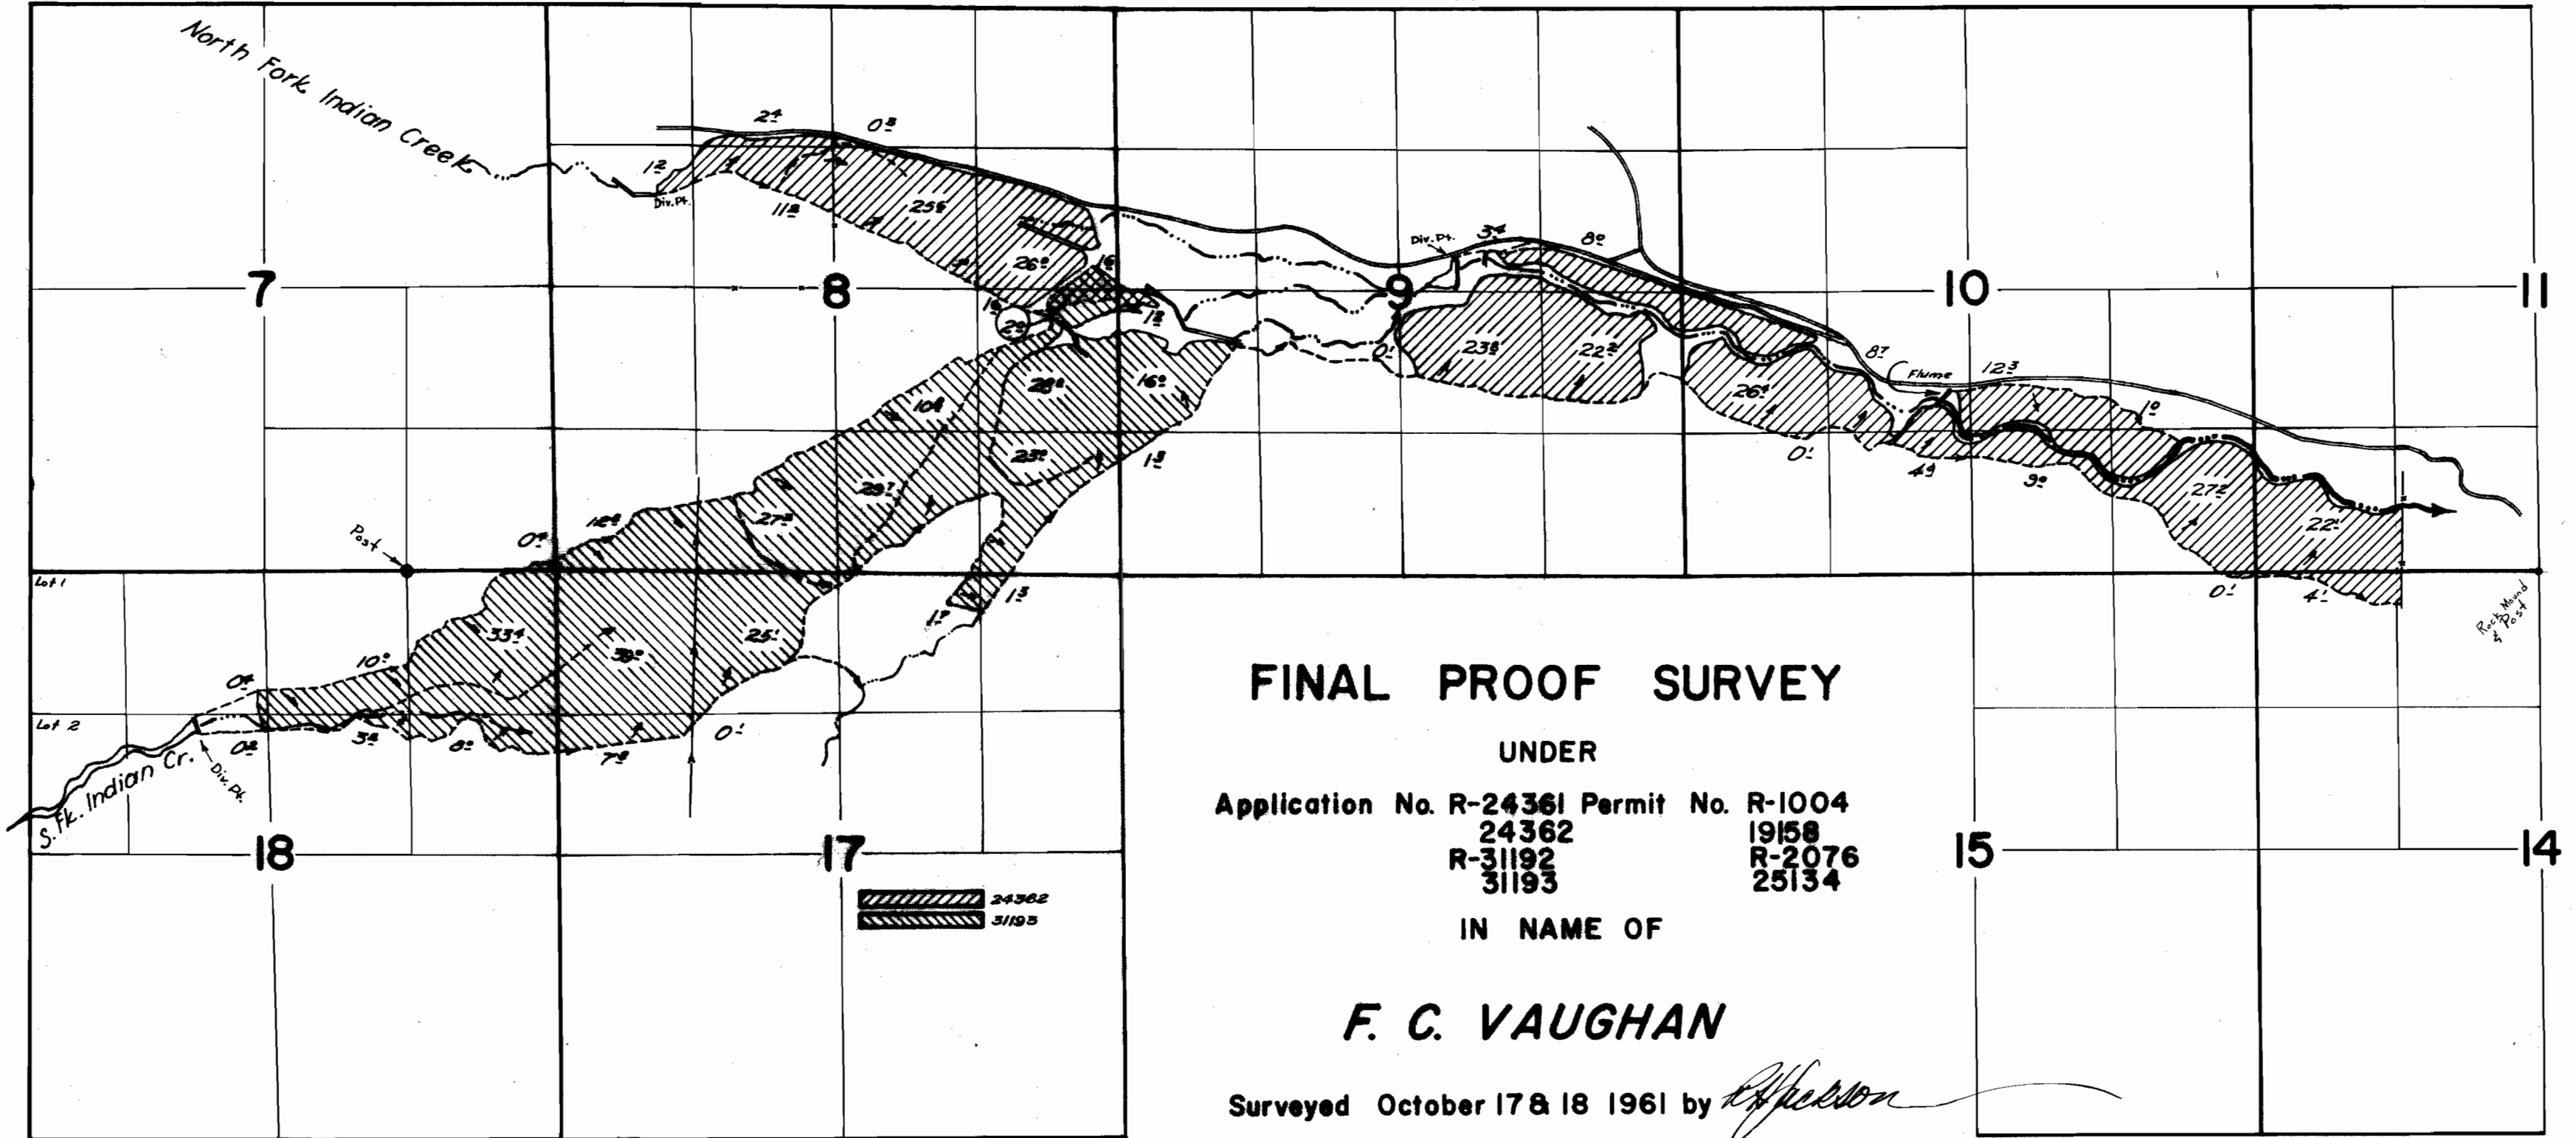

FINAL PROOF SURVEY

UNDER

Application No. R-24361 Permit No. R-1004
24362 19158
R-31192 R-2076
31193 25134

IN NAME OF

F. C. VAUGHAN

Surveyed October 17 & 18 1961 by *R. Johnson*

1961-G
55C-16N-163
55C-17N-141