


T. 8S. R. 39E. W.M.

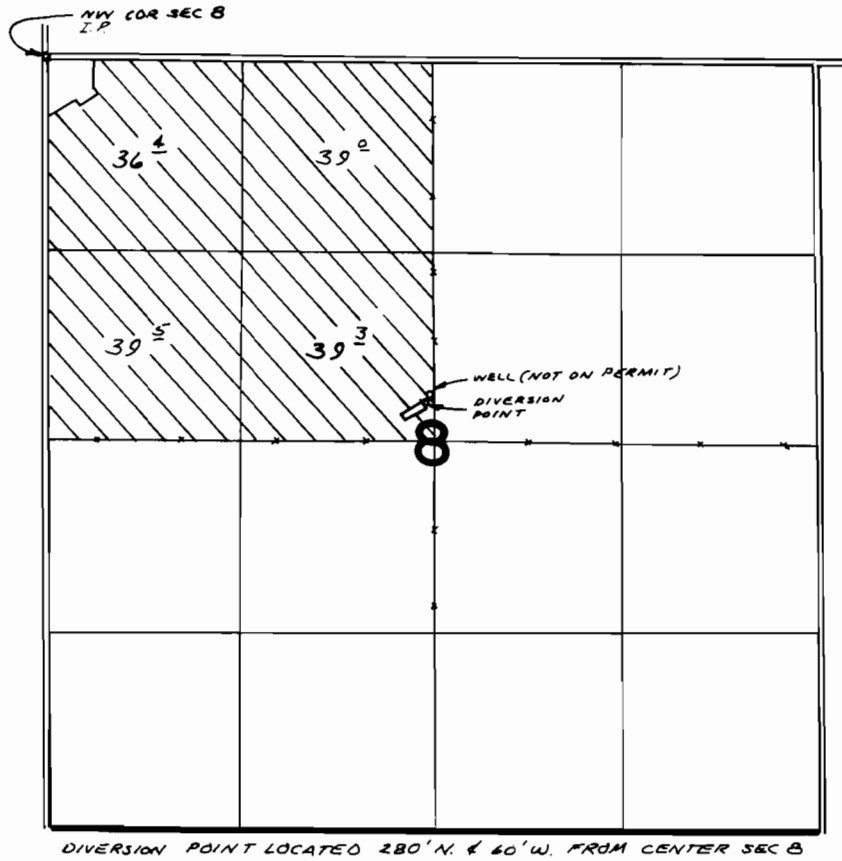

FINAL PROOF SURVEY UNDER

Application No. G.6561 Permit No. G.6162
IN NAME OF

Blaine Dee Allen

Surveyed OCT 26 1977, by R. BARWIN

BBB-4KK-240
PTS-1977-5-B