


T. 10S. R. 40E. W. M.

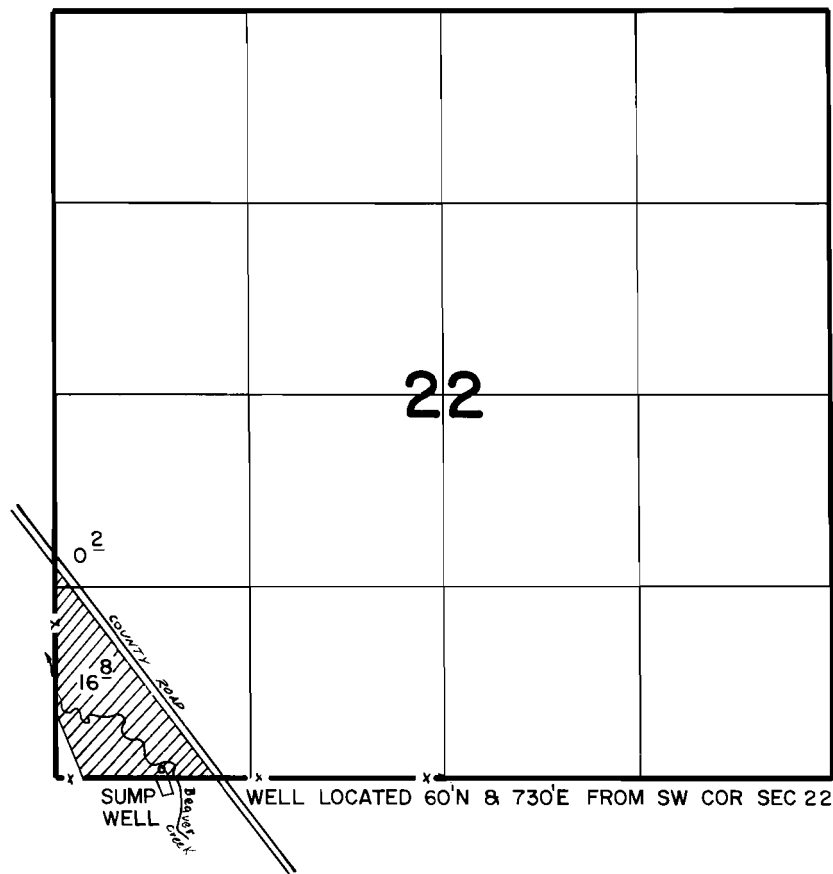

FINAL PROOF SURVEY
UNDER

Application No. G-6415 Permit No. G-6829
IN NAME OF

EUGENE M. & JOAN E. DAVILLA

Surveyed 11-2 1978, by R. DARWIN