


T. 10S. R. 40E. W.M.

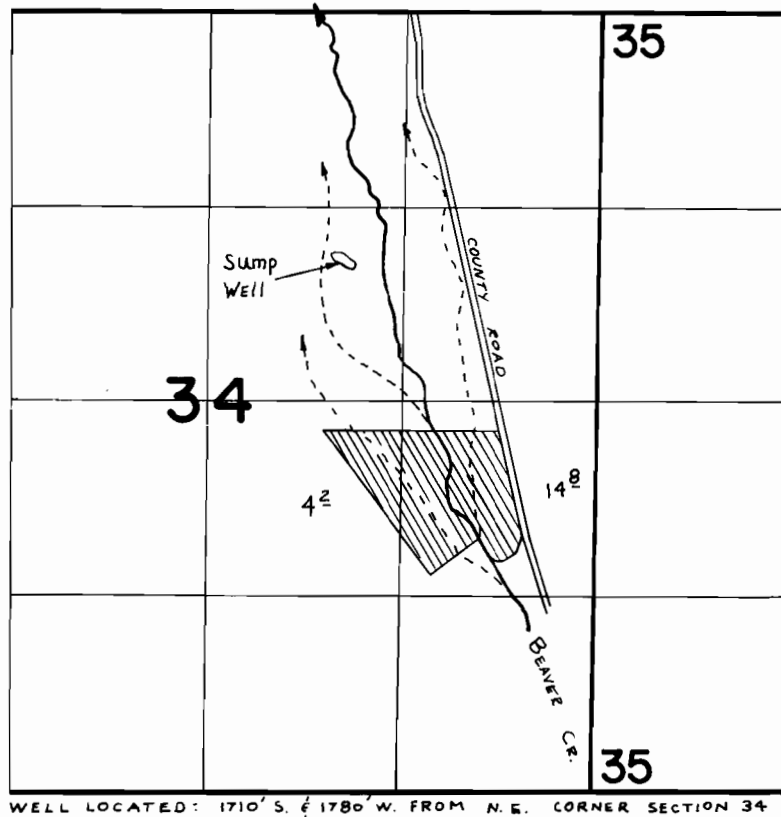

FINAL PROOF SURVEY
UNDER

Application No. **G-7562** Permit No. **G-7028**
IN NAME OF

EUGENE M. DAVILLA

Surveyed 11-2 1978, by R. BARWIN