


T. 5S. R. 3E.W.M.

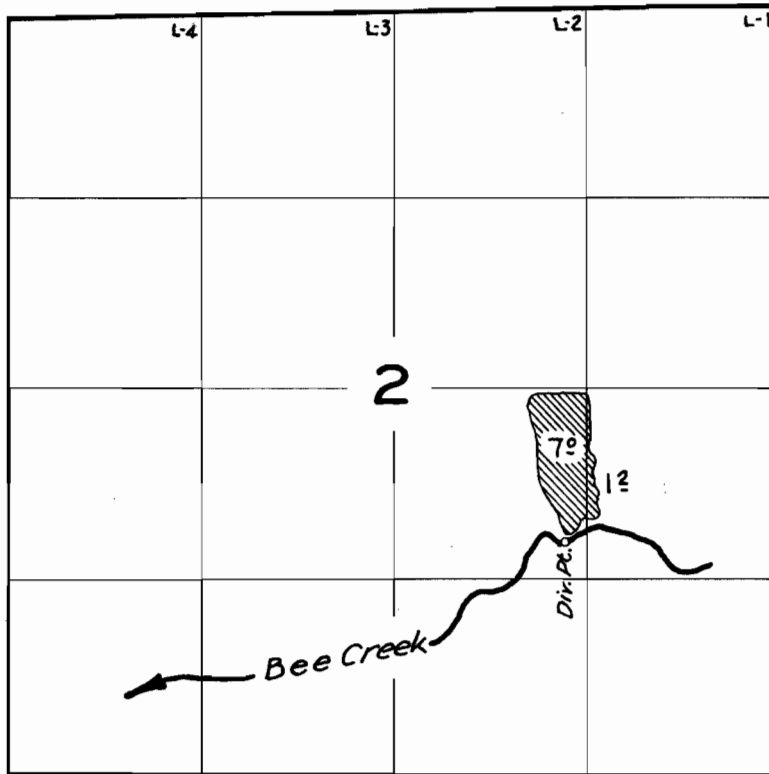

**FINAL PROOF SURVEY**  
UNDER

Application No. 25253 Permit No. 19838  
IN NAME OF

**M. J. DELAPP**

Surveyed 18 June 1958, by C.O. Bartels.