


Township No. 14 S Range 27 E W. M.

Grinnell

County, Ore

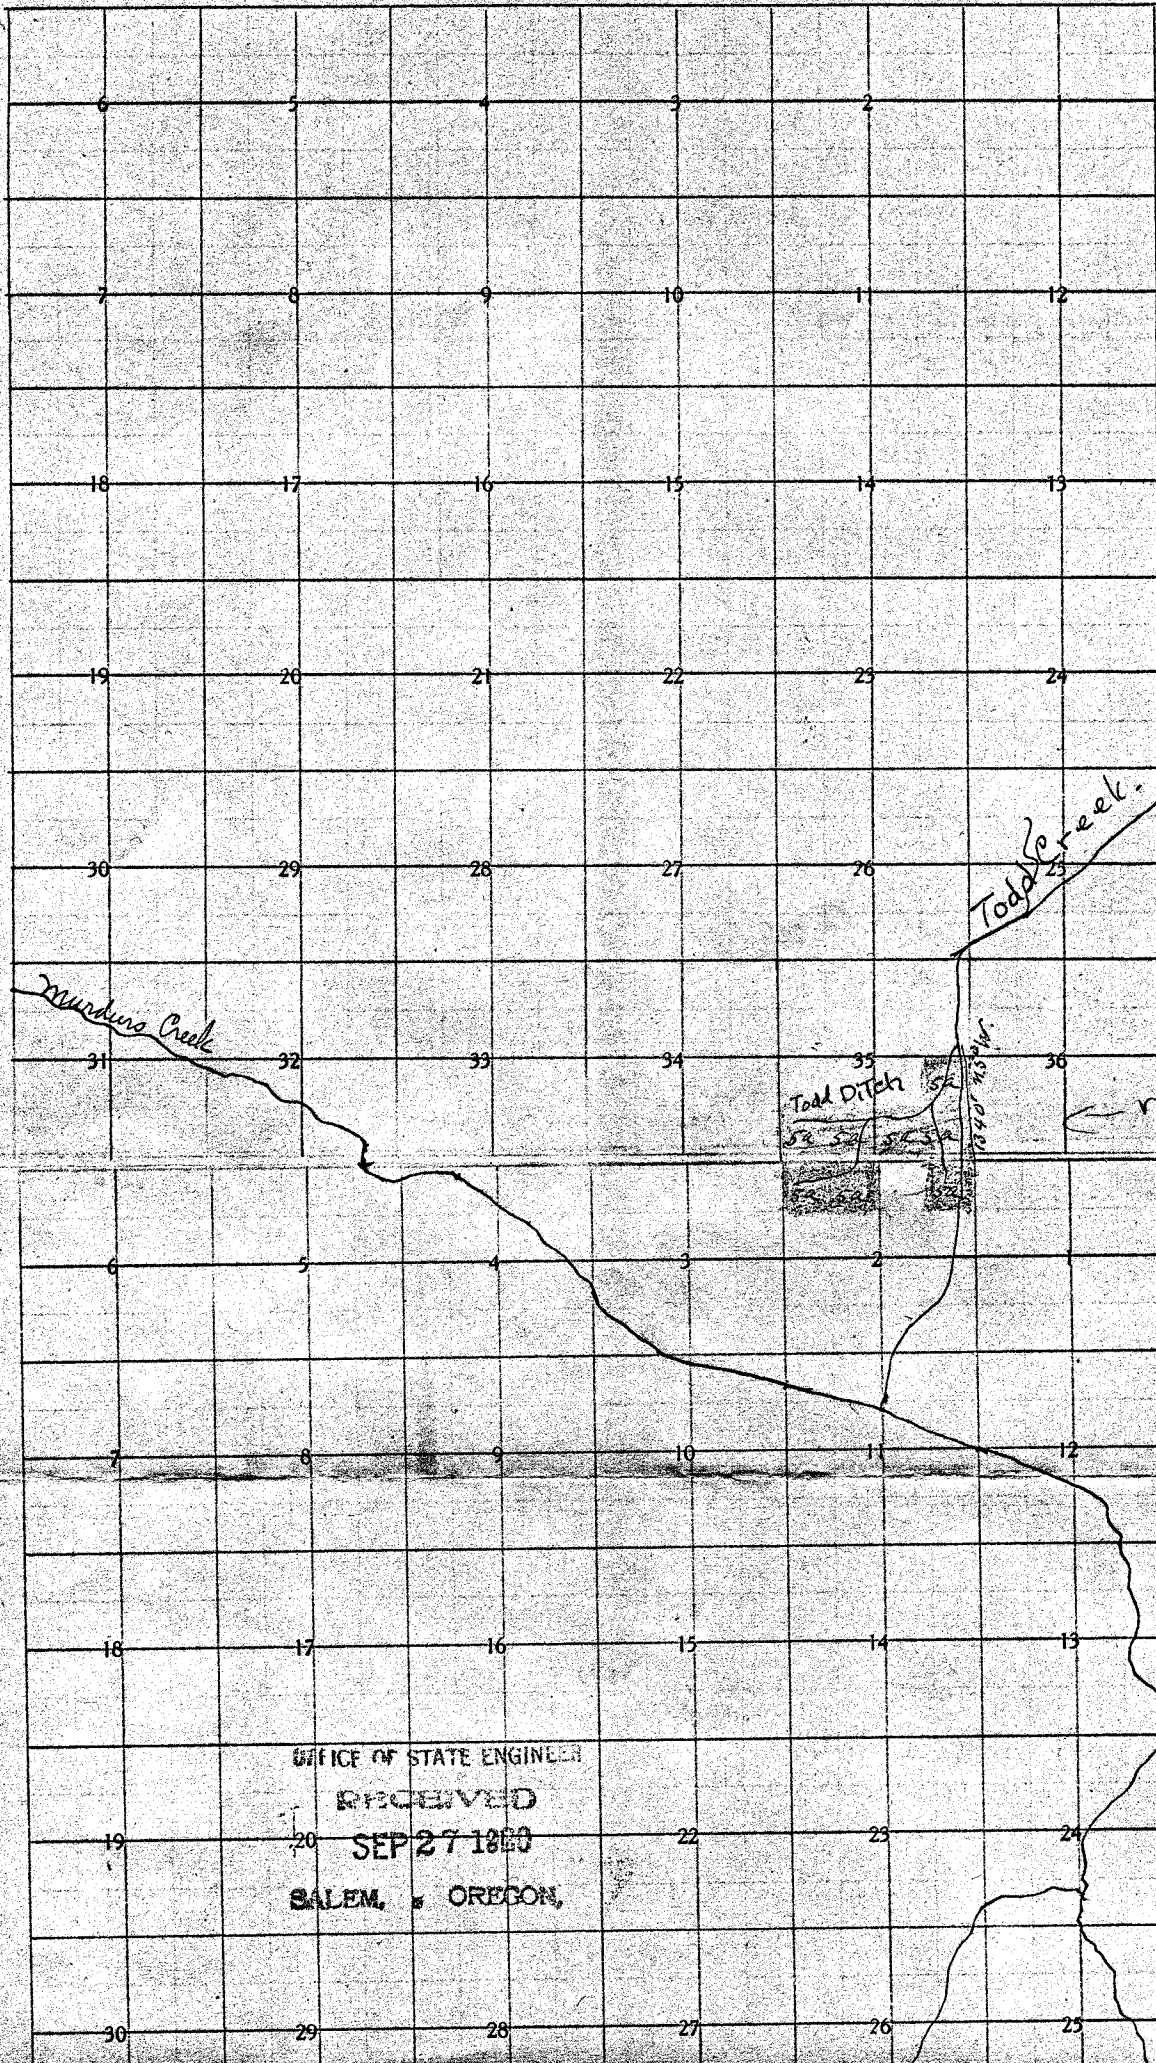

T 15 S.
R 27, E


OFFICE OF STATE ENGINEER

RECEIVED


SALEM, OREGON,

T 15.5
R 27. E

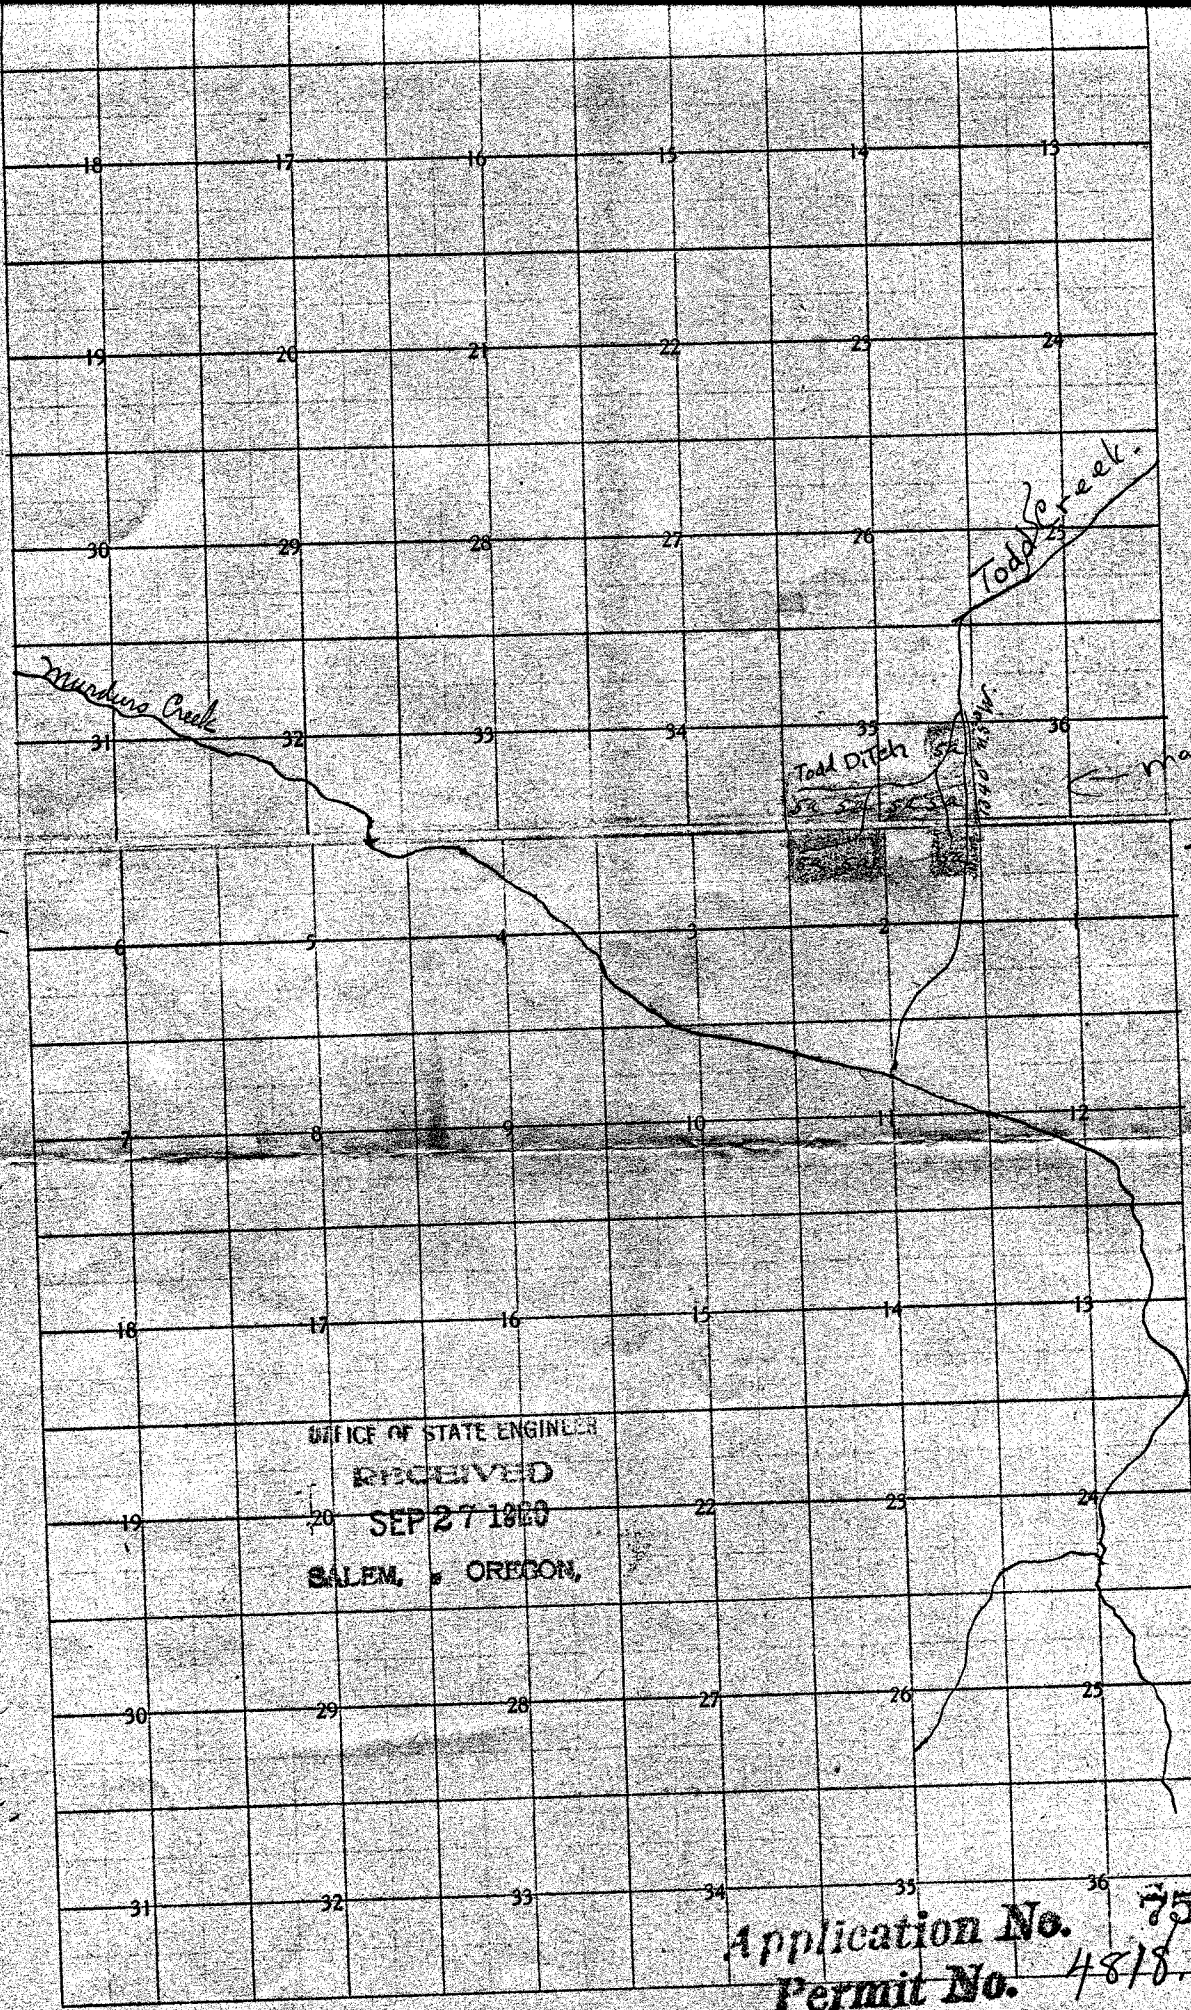

map shows
200 ac
covered?
instead of
256 ac
in Section 35

OFFICE OF STATE ENGINEER
RECEIVED
SEP 27 1960
SALEM, OREGON

Application No. 7551
Permit No. 4818

