T.23S. R.7W. W.M.

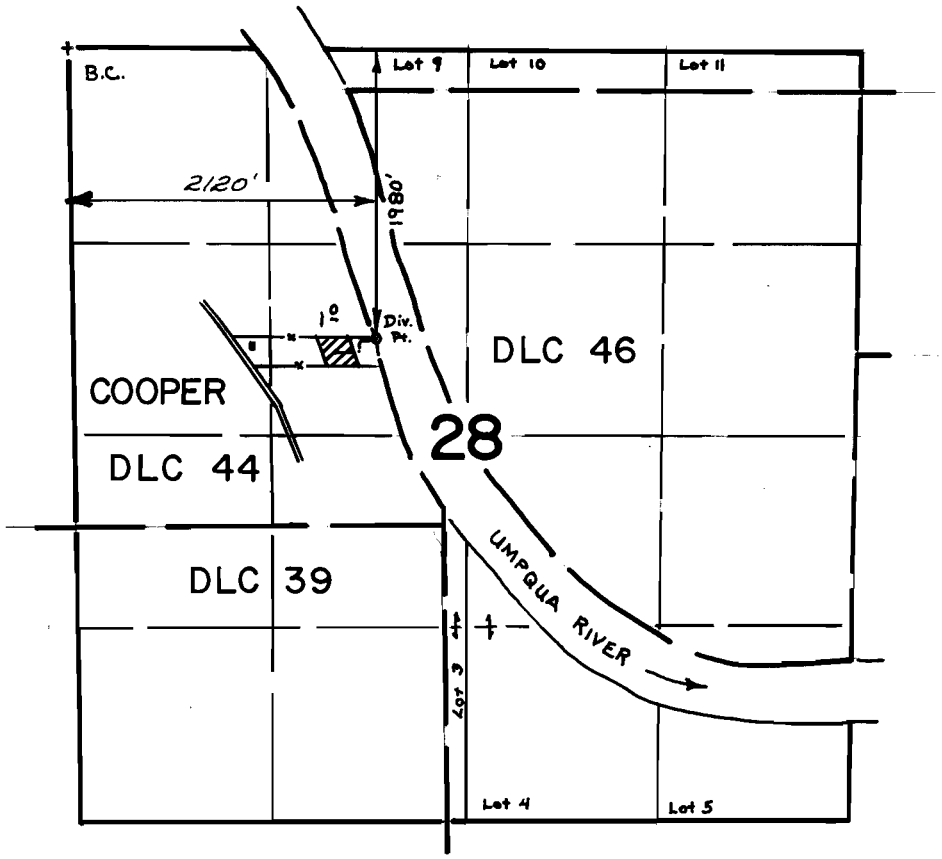

SCALE: 4" = 1 mile

FINAL PROOF SURVEY
UNDER

Application No. 53193 Permit No. 39470
IN NAME OF

MARILYNN L. SAEGER

Surveyed Aug. 20 1979, by S. Donaldson