


T.40S.R.35E.W.M.

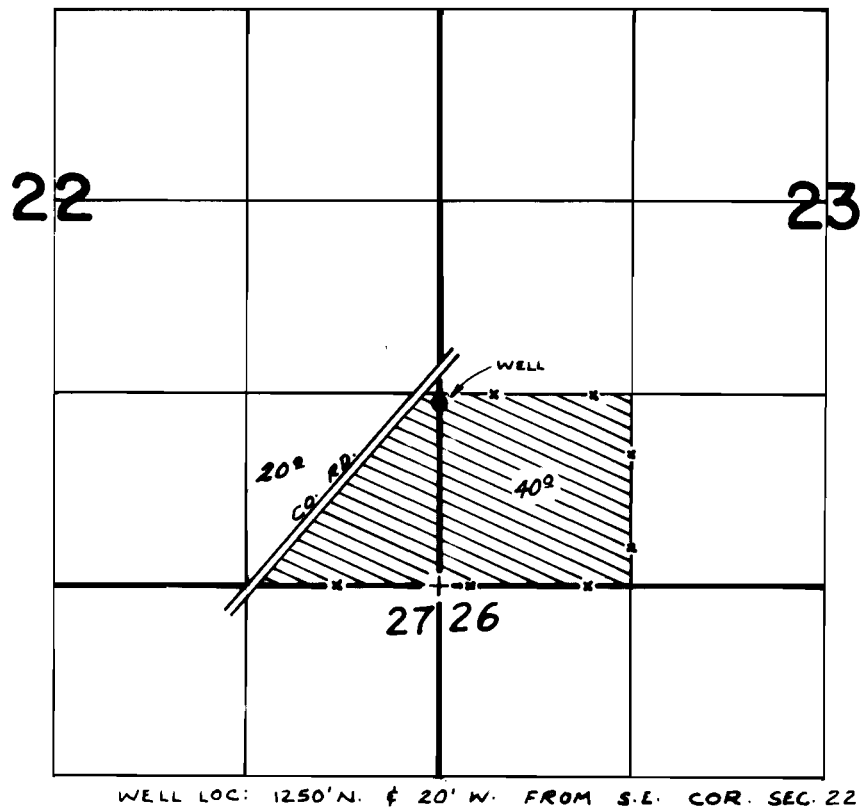

FINAL PROOF SURVEY
UNDER

Application No. G-5507 Permit No. G-5173
IN NAME OF

.....EDWIN D. FARNHAM, JR.

Surveyed AUG. 25, 1978, by R. MUCKEN