


T. 35 S., R. 2 W., W.M.

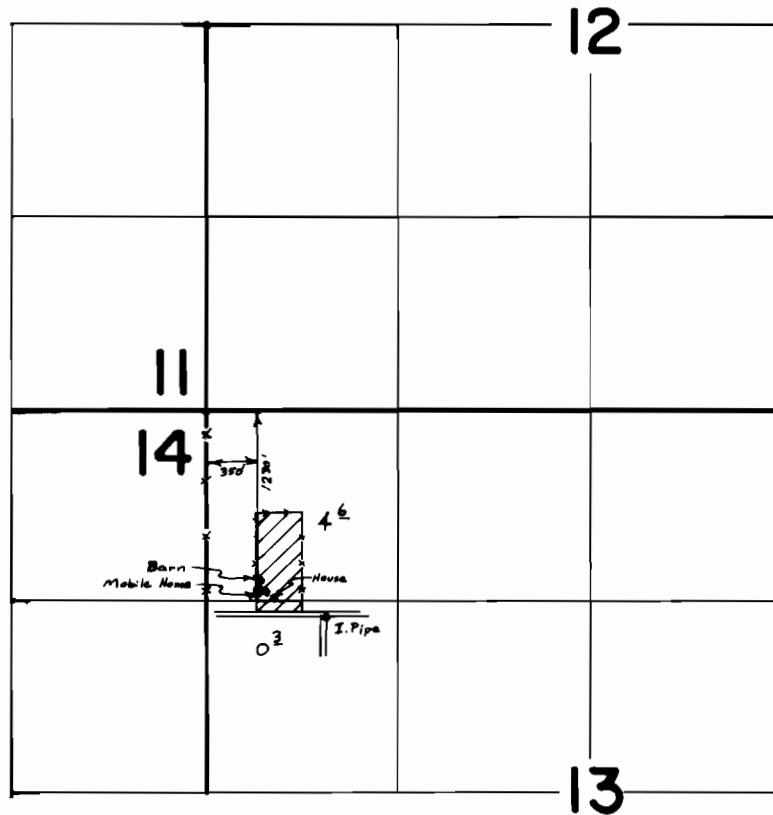

**FINAL PROOF SURVEY**  
UNDER

Application No. G-6068 Permit No. G-5758  
IN NAME OF

LYONNE AL &/or MAY M. BROKOFSKY

Surveyed MAY 30, 1978, by B.R. SUND