


T.34 S., R.1 W., W.M.

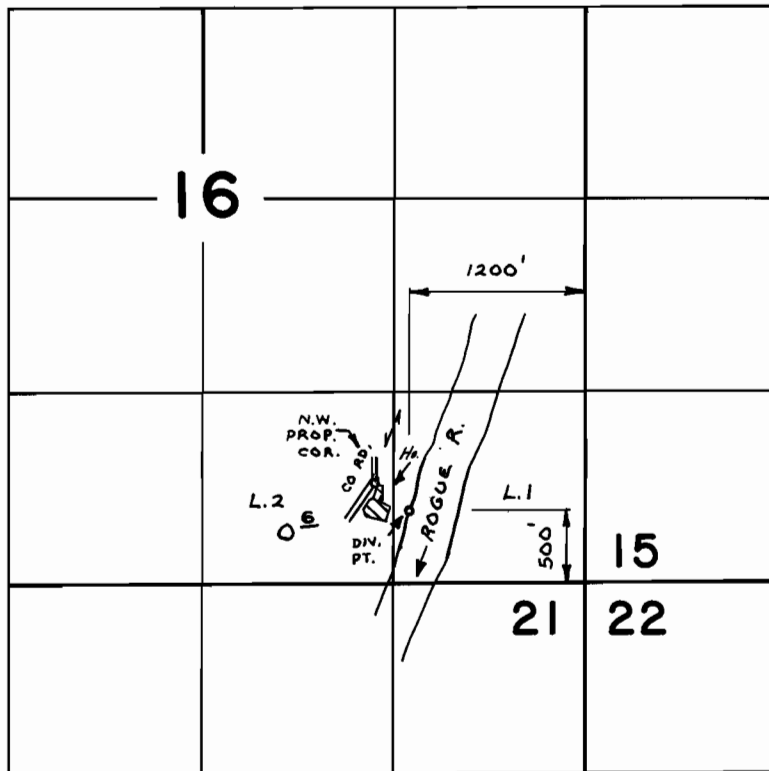

FINAL PROOF SURVEY
UNDER

Application No. 46970 Permit No. 35144
IN NAME OF

Sherman R. Masler M.D.

Surveyed OCT. 19 78 by B. SUND
19.....