


T.38 S., R.7 W., W.M.

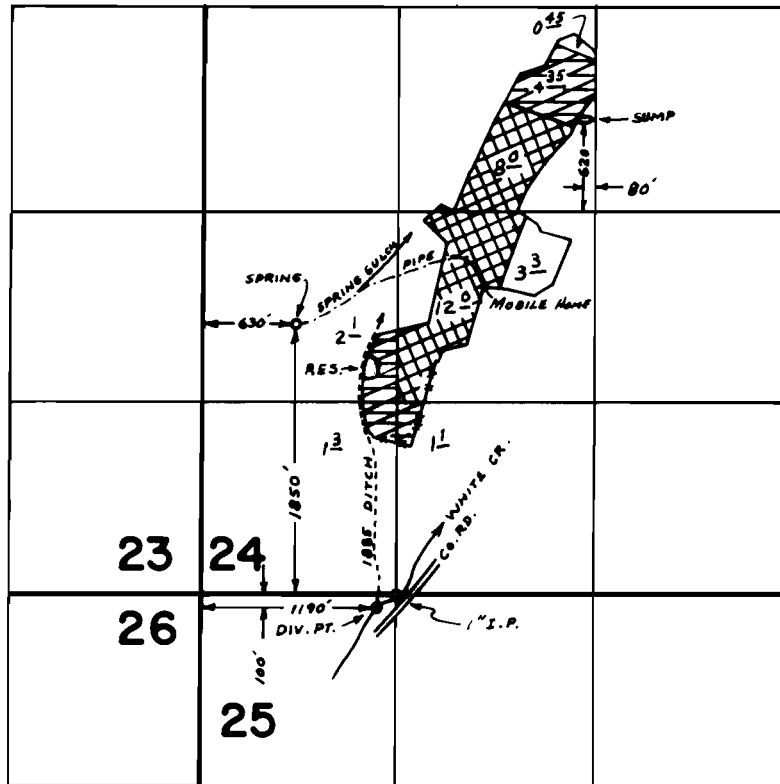

RES. LOC. : 1530' N. & 1190' E. FROM SW COR. SEC. 24

-  - PRIMARY (RESERVOIR)
-  - SUPPLEMENTAL (RES.)
-  - SUPPL. (SUMP WELL)

FINAL PROOF SURVEY

UNDER

G-5358

G-4957

R-47703

R-5760

Application No. 47704 Permit No. 35736
IN NAME OF

HAROLD MESSINGER

Surveyed JUL. 24 1978, by B. SUND