


T. 17S., R. 6W., W.M.

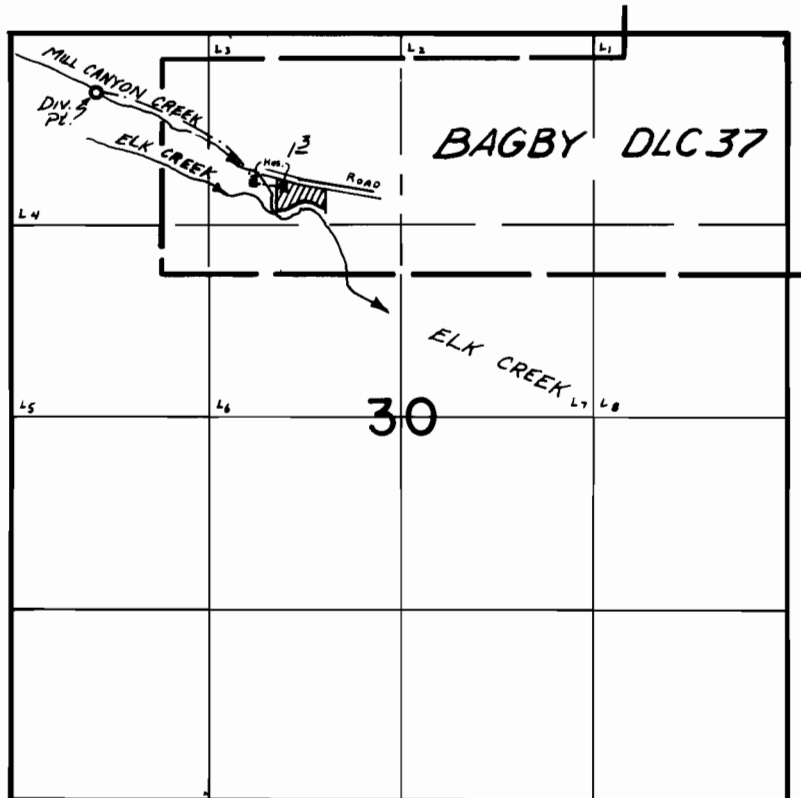

DIV. PT. LOC.: 410'S. & 580'E. from NW Cor. Sec. 30

FINAL PROOF SURVEY
UNDER

Application No. 52941 Permit No. 39970

IN NAME OF
Herbert & Margaret Ernst

Paul S. Forman

Surveyed May 12, 19 by L. Nunn