


T.13S., R.11W., W.M.

SECTION 6

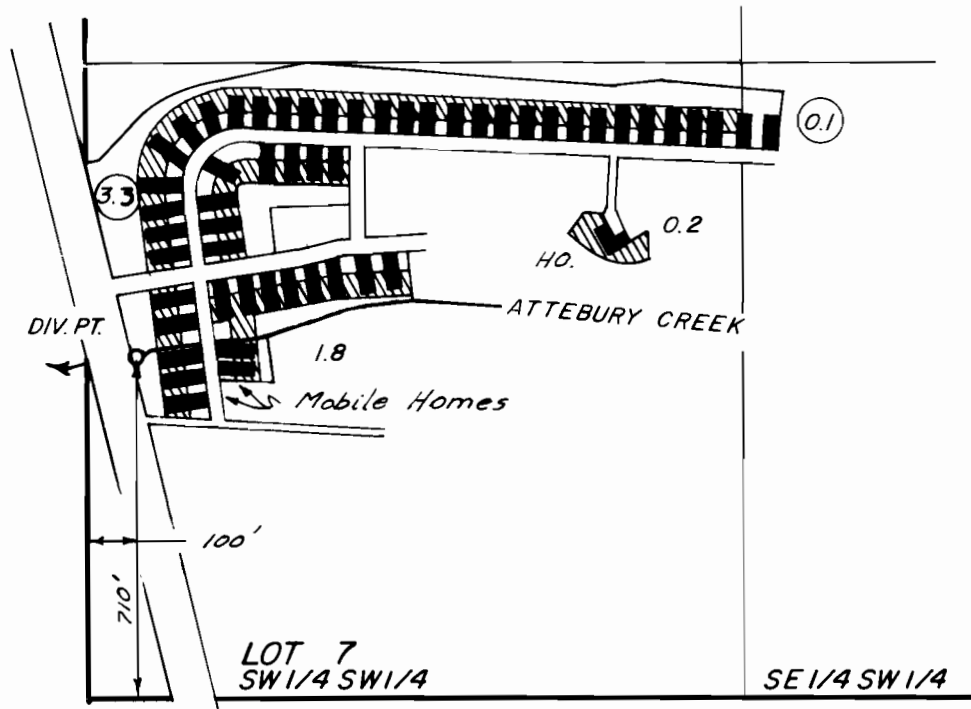

SCALE 1" = 400'

0.0 OVER ACREAGE

FINAL PROOF SURVEY
UNDER

Application No. 49711 Permit No. 36787

IN NAME OF

RAY ATTEBURY

Surveyed Sept. 29, 1979, by *Al Brown*