


T.I.S., R.I.W., W.M.

SCALE 1" = 660'

24

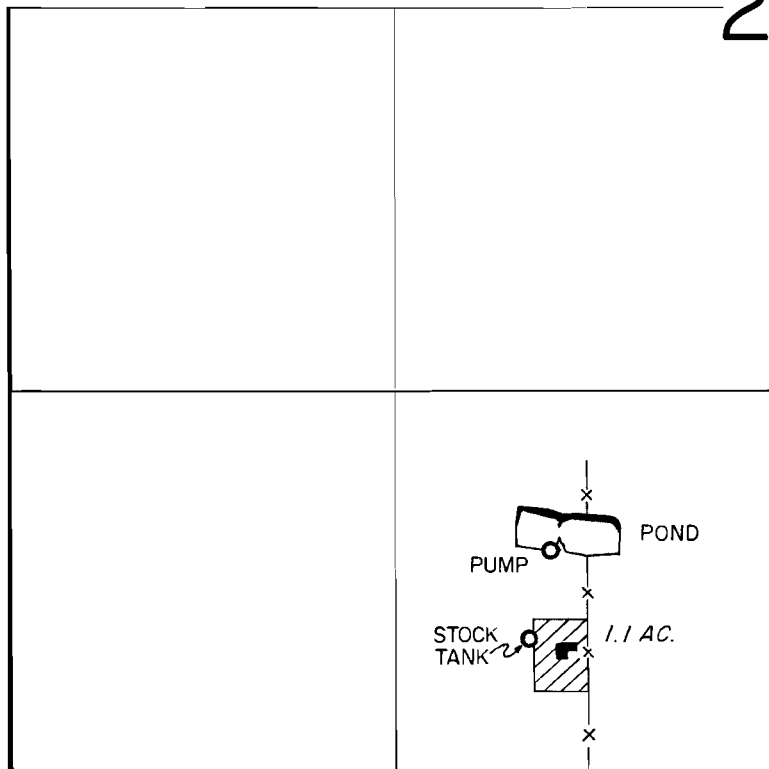

FINAL PROOF SURVEY UNDER

R-49670 R-5906
Application No. 49671... Permit No. 36522.....
IN NAME OF

JOHN & NANCY CALVIN

Surveyed SEPT. 2, 1978, by J. DONALDSON.
Inspection May 2, 1979 by S.C. Brown