


# T13S. R1E. W1M.

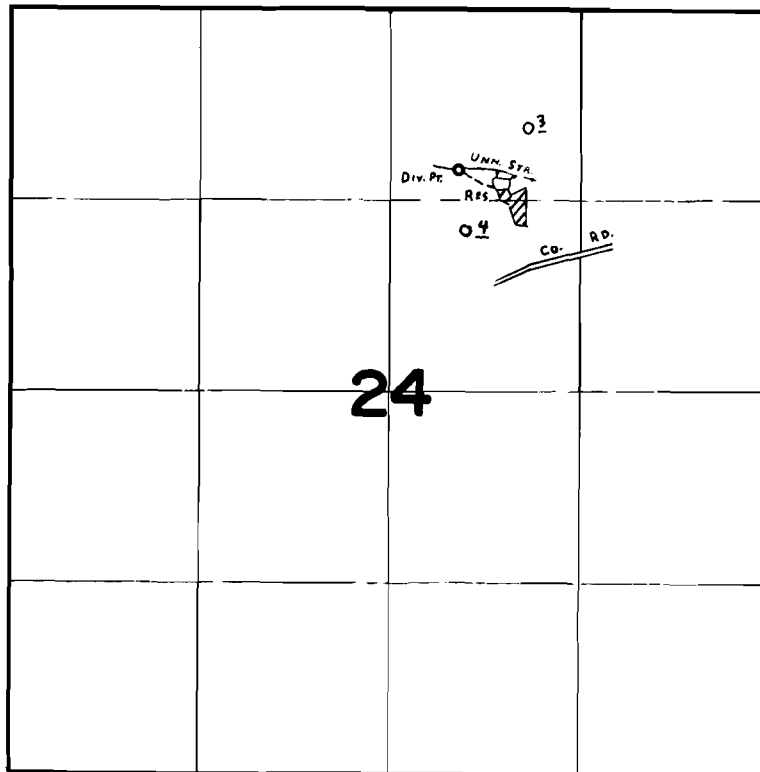

Div. Pt. Loc: 1530'S. & 2130'W. }  
Res. Loc: 1430'N. & 1830'W. } BOTH FROM E. 1/4 COR. SEC. 24.

## FINAL PROOF SURVEY UNDER

Application No. 41275 R-41274 Permit No. 32255 R-4931  
IN NAME OF

HOMER & MAMIE V. ROBINETT

Surveyed MAY 2 1978, by C. L. HUGHES