


T13S. R1E. W1M.

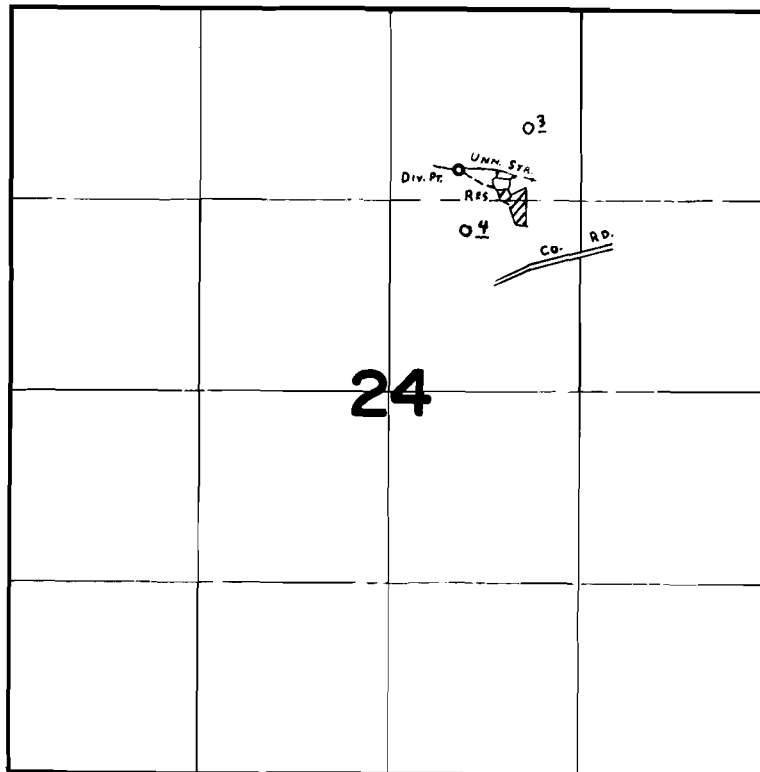

Div. Pt. Loc: 1530' S. & 2130' W. }
Res. Loc: 1430' N. & 1830' W. } Both From E. 1/4 COR. SEC. 24.

FINAL PROOF SURVEY UNDER

Application No. 41275 R-41274 Permit No. 32255 R-4931
IN NAME OF

HOMER & MAMIE V. ROBINETT

Surveyed MAY 2 1978, by C. L. HUGHES