


T.15S.R.46E.W.M.

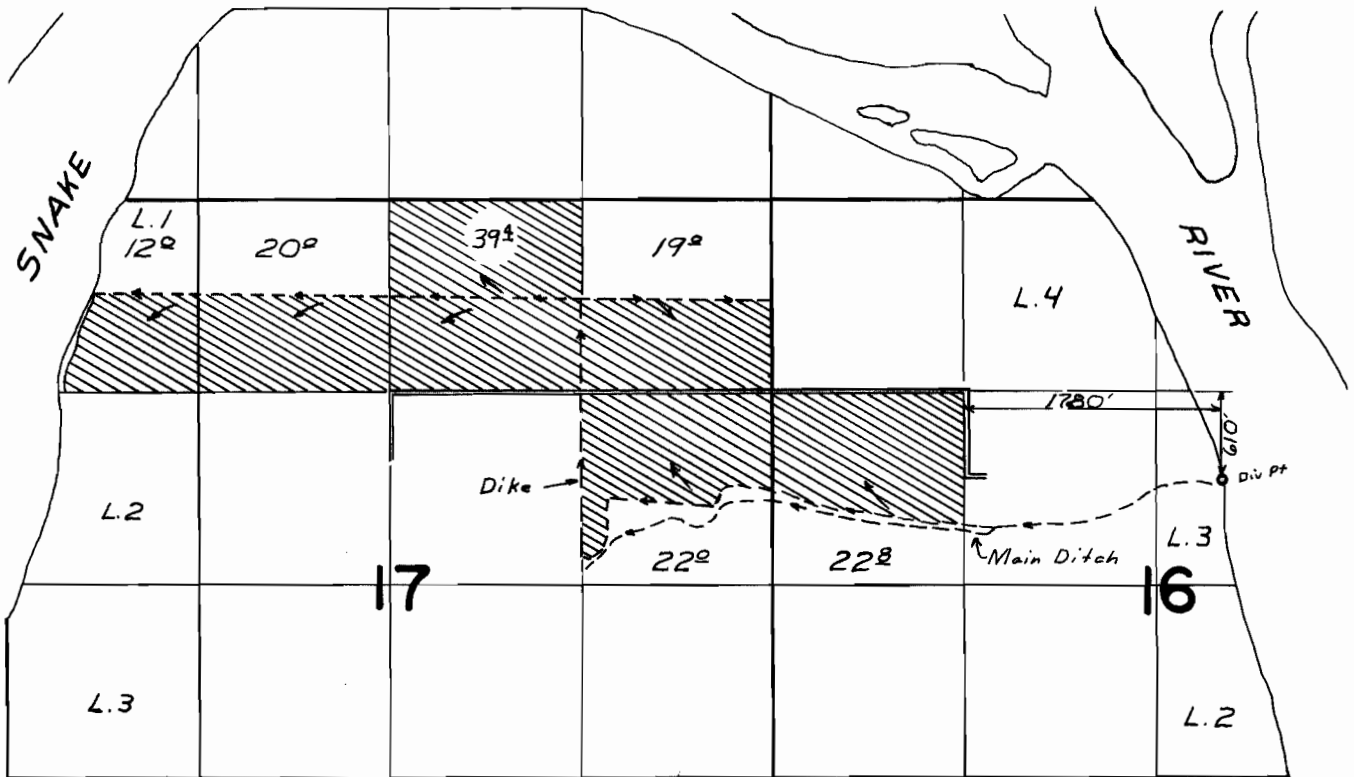

**FINAL PROOF SURVEY**  
UNDER

Application No. 39426 Permit No. 29379  
IN NAME OF

Paul J. Damby

Surveyed Oct. 31, 1967, by W. J. Ruppert