


# T.6S.R.2W.W.M.

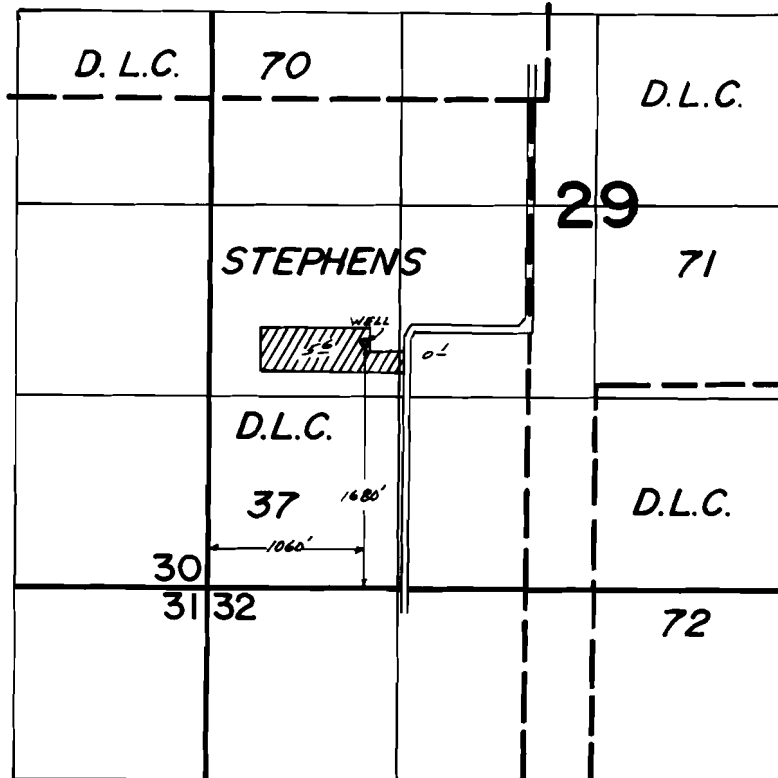

## FINAL PROOF SURVEY UNDER

Application No. G-5252 Permit No. G-5105  
IN NAME OF

*Terry L. & Kiyoko Conaway*

Surveyed Oct. 9 1978, by J.S. Donaldson