


G-2409

51157
35394

T. 1 N. R. 26 E. W. M.

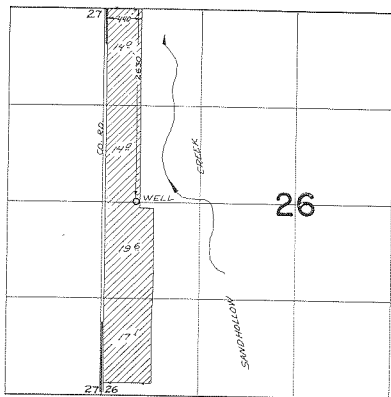

FINAL PROOF SURVEY UNDER

Application No. G-2695.. Permit No. G-2409
IN NAME OF

KENNETH TURNER

Surveyed June 21, 1967, by L.E. Gould.....