


G-4255

39079
51158

T.1N.R.26E.W.M.

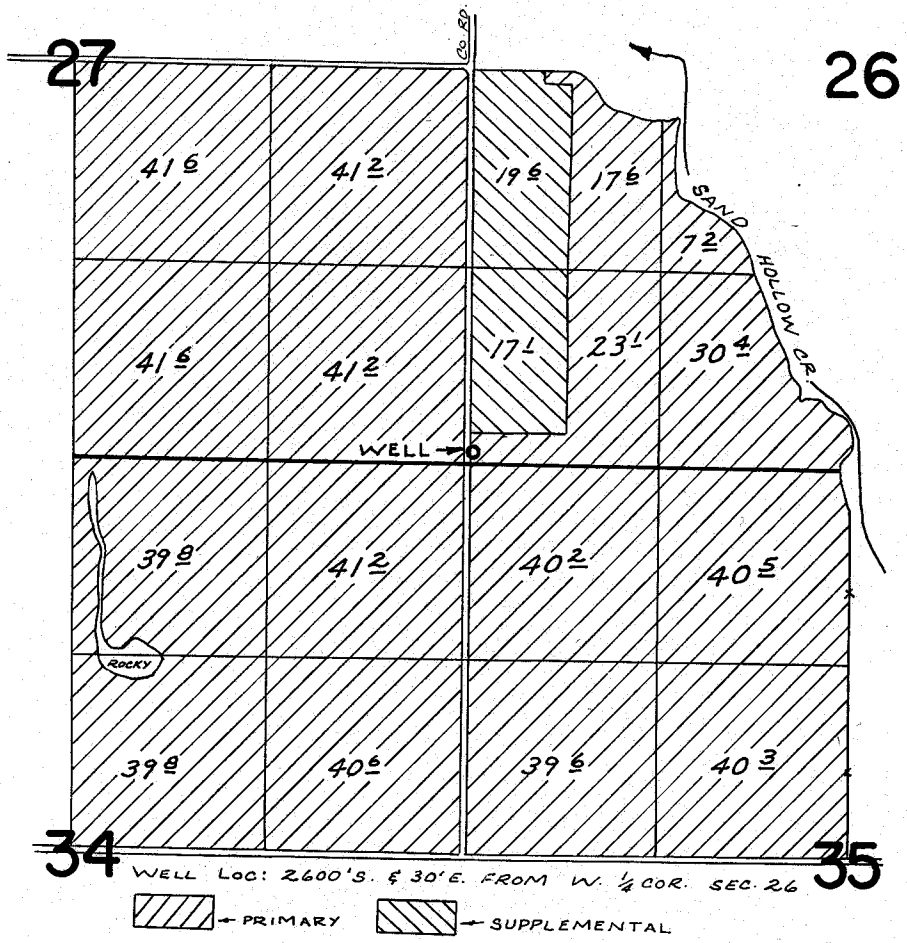

FINAL PROOF SURVEY UNDER

Application No. G-4516 Permit No. G-4255
IN NAME OF

KENNETH TURNER

Surveyed JUNE 22 1971, by R. MUCKEN