


# MAP OF DIVERSION POINT of WATER APPLIED FOR.

By J. M. THOMPSON


Camas Valley, Ore Dec. 31. 1920

Scale 1 inch to 40 Ch's

Surveyors Certificate

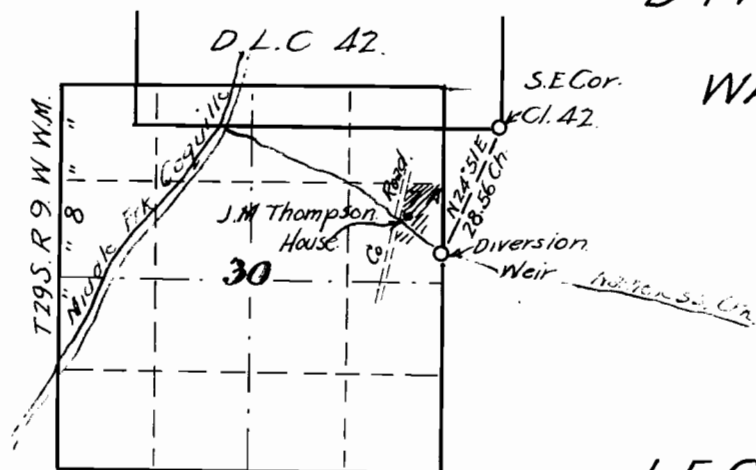

I. F. C. Frear of Roseburg Ore. do hereby certify that this map was made from notes taken during an actual Survey made under my immediate Supervision on, Dec 30 1920 and that it Correctly represents the works described in the accompanying application, together with the location of the streams in the immediate vicinity.

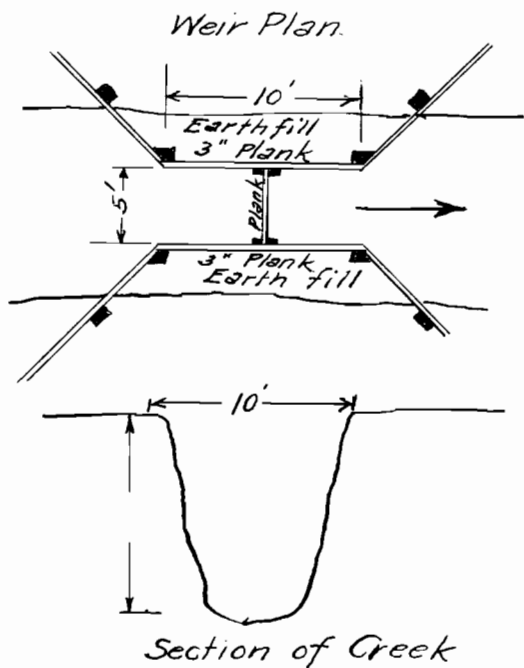

F. C. Frear.

7689  
4894