


T.7S.,R.5W.,W.M.

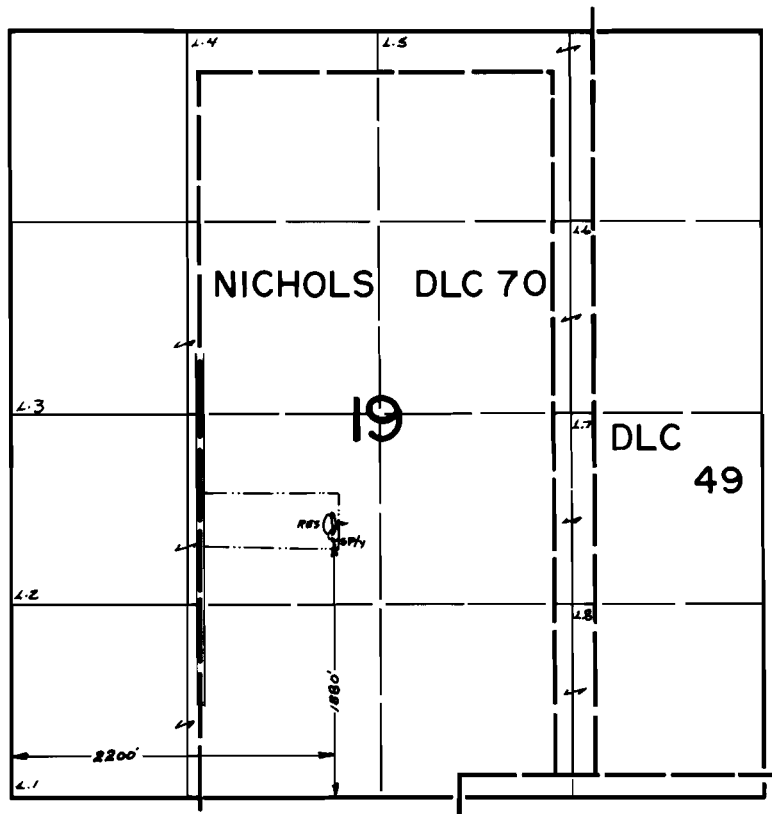

**FINAL PROOF SURVEY**  
UNDER

Application No. R-54660 Permit No. R-6537....  
IN NAME OF

**JAMES POTTER**

Surveyed Oct. 15, 1981, by L. TOLL