


# T.2N. R.16E. W.M.

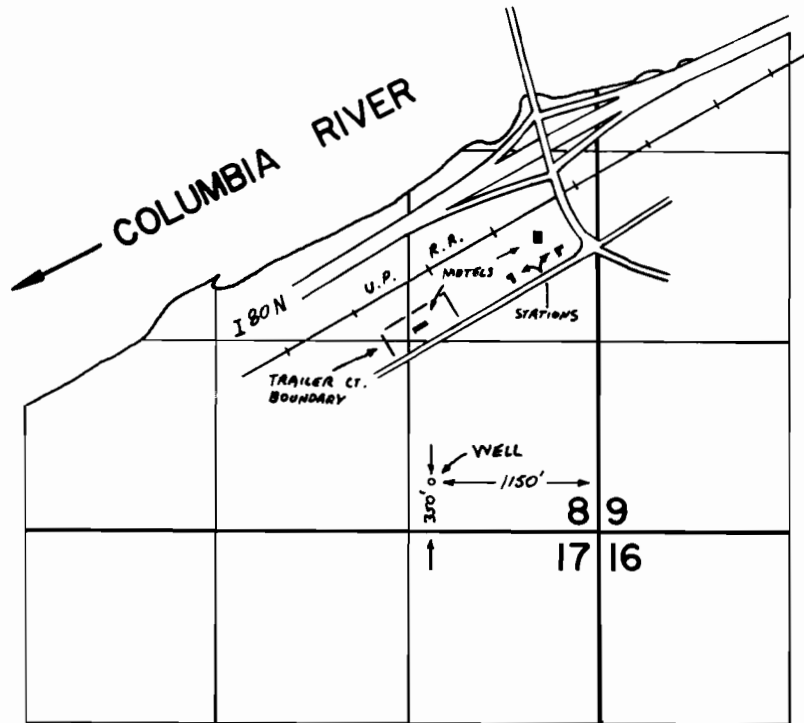

## FINAL PROOF SURVEY UNDER

Application No. G-2846 Permit No. G-4735  
IN NAME OF

ISAMI TSUBOTA

Surveyed JULY 15 1976, by R. G. MUCKEN