


T. 1 S., R. 9 W., W.M.

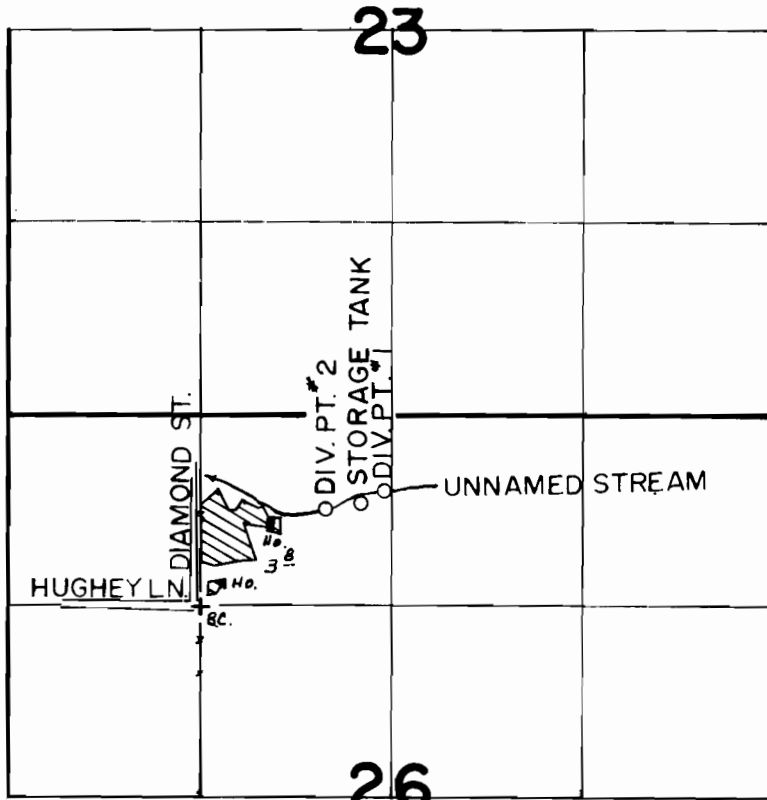

DIV. PT. LOC: #1- 800' N. & 1250' E., #2- 670' N. & 850' E.,
 BOTH FROM SW COR. NE 1/4 NW 1/4 SEC. 26.

FINAL PROOF SURVEY UNDER

Application No. 49782... Permit No. 37281.....
 IN NAME OF

ED. GOLLON

Surveyed MAY 9... 1978, by J.S. DONALDSON