
T. 4N.R. 28E.W.M.

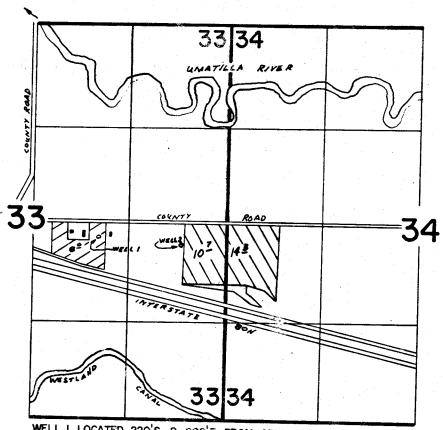

WELL I LOCATED 220'S & 900'E FROM CENTER SEC 33
WELL 2 LOCATED 310'S & 630'W FROM E1/4 COR. SEC 33



PERMIT G-6730

FINAL PROOF SURVEY

G-6409 G-6730 Application No. G-6310 Permit No. G-6790 IN NAME OF

DOUBLE "M" RANCH, INC.

Surveyed II-30 1977, by R. BARWIN