
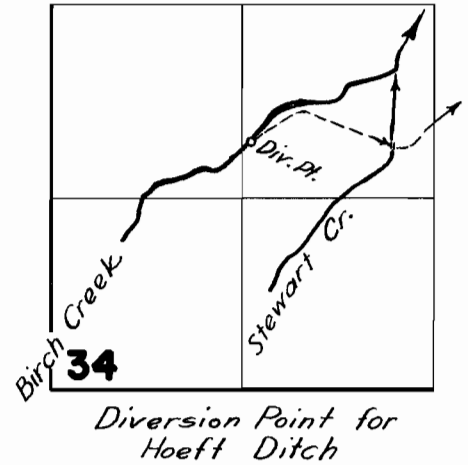


T. IN. R. 32 E. W. M.

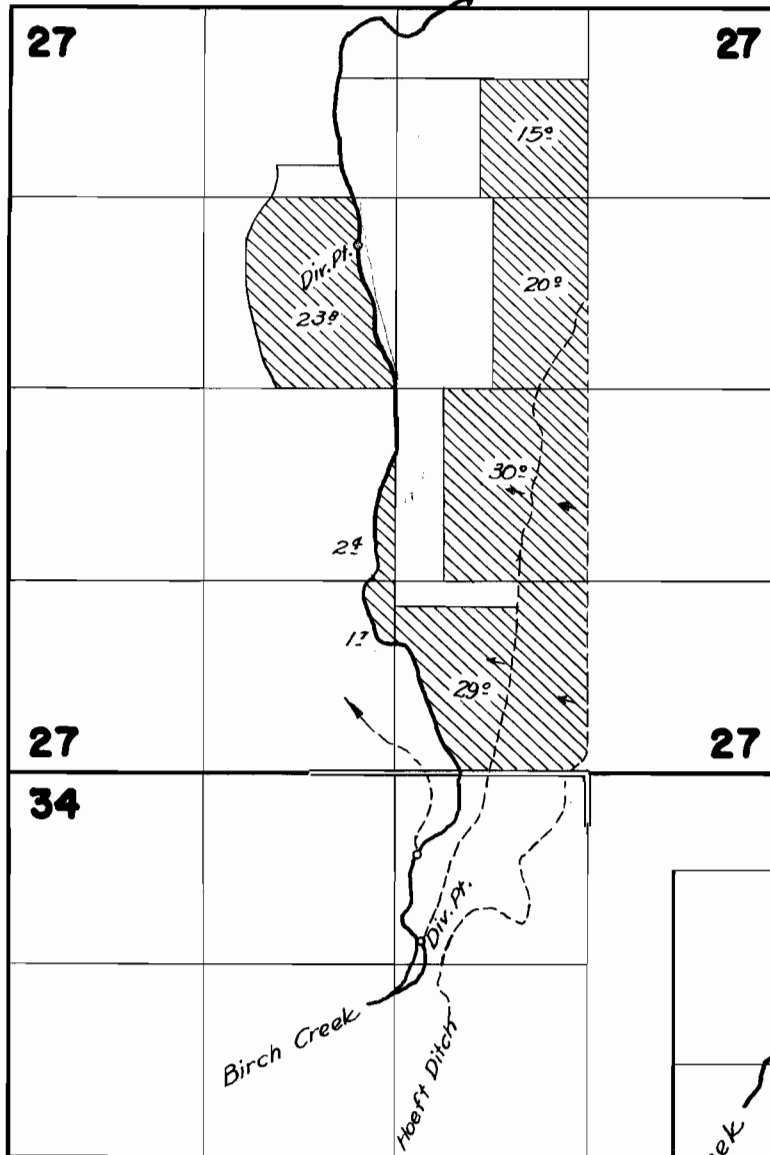

Diversion Point for
Hoeft Ditch


FINAL PROOF SURVEY UNDER

Application No. **31327**... Permit No. **24830**...
IN NAME OF

EDWIN HOEFT

Surveyed July 18 1960, by *A. J. Johnson*
Sept. 18 1961, by *C. O. Bartels*

T. 1N. R. 32 E. W. M.

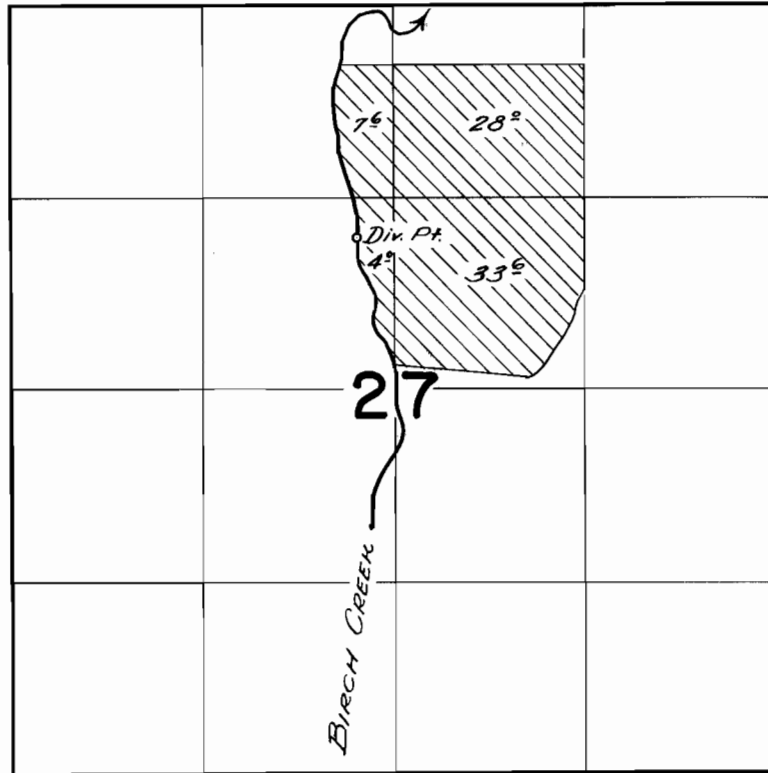

FINAL PROOF SURVEY UNDER

Application No. 31327.. Permit No. 24830..
IN NAME OF

..... EDWIN HOEFT

Surveyed Sept. 18. 1961., by C.B. Bartels