


T. 1S., R. 38E., W. M.

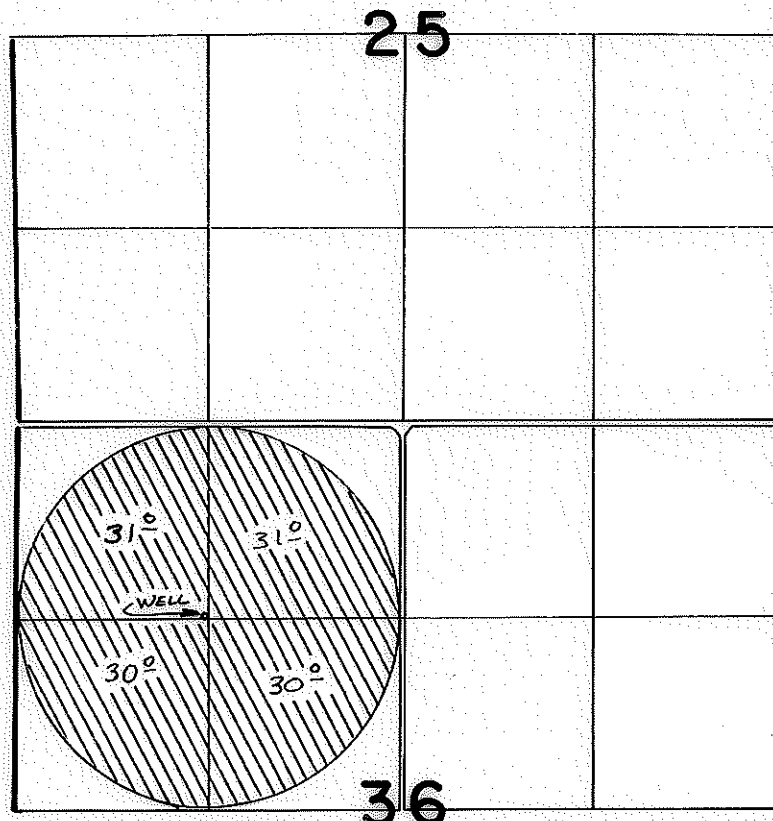

WELL LOCATED 1320'S & 1290'E. FROM NW. COR. SEC. 36 T.1S. R.38E.

FINAL PROOF SURVEY
UNDER

Application No. G-7384 Permit No. G-6870
IN NAME OF

B. L. DAVIS RANCH, INC.

Surveyed 11-18 1981, by V.L. Church