


T. 2S.R.1W.W.M.

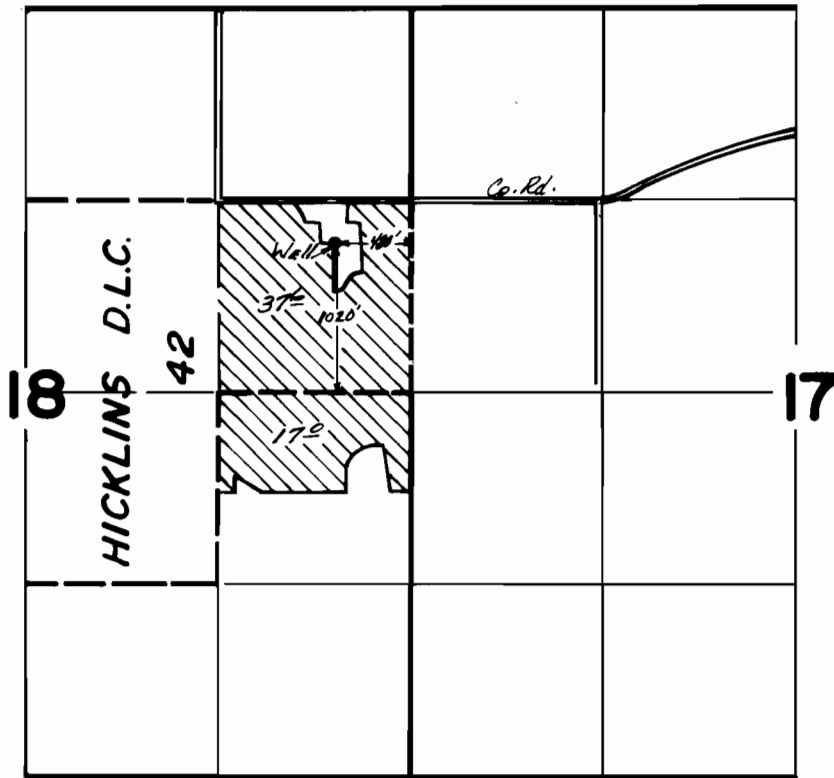

FINAL PROOF SURVEY UNDER

Application No. G-5501 Permit No. G-5476
IN NAME OF

Porter Watten Co., Inc.

Surveyed July 24, 1978, by R.G. Mucken