


T.5S.R.3W. W.M.

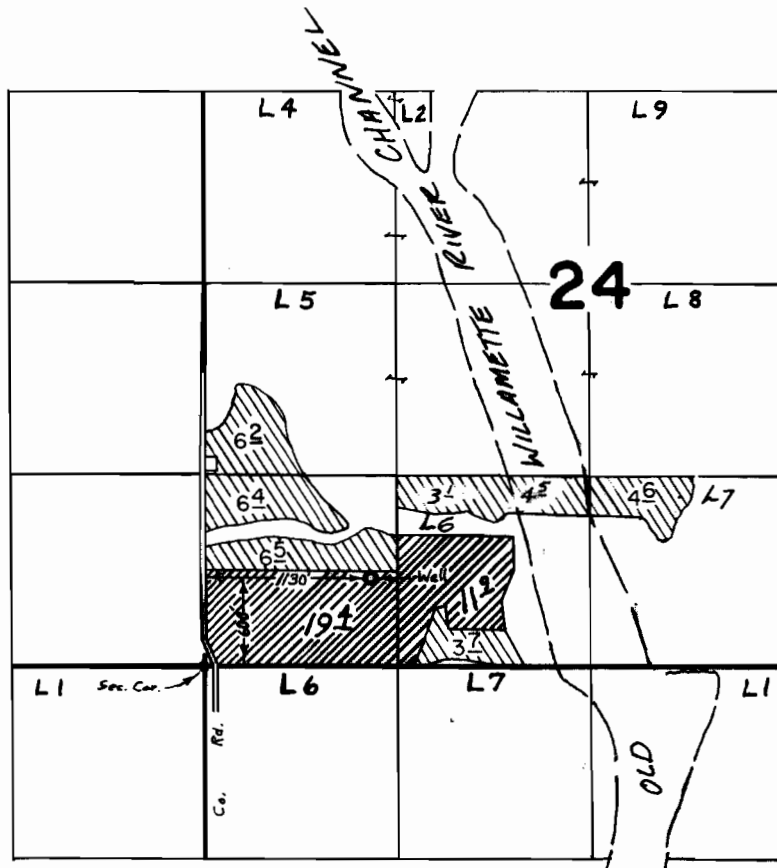

FINAL PROOF SURVEY
UNDER

G-7748 G-7177
Application No. *G-3120* Permit No. *G-2927*
IN NAME OF

ARNOLD E. HILDEBRANDT

Surveyed *April 7, 1967*, by *L.E. Gould*
MAY 28, 1980, *[Signature]*

