


T. 7S., R. 38E., W.M.

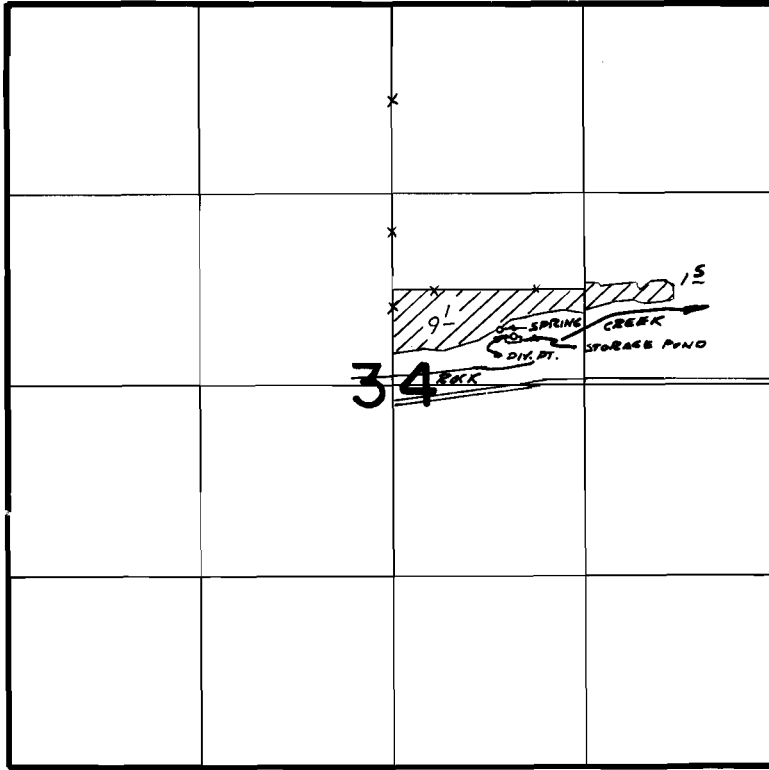

SPRING LOC: 1040' N. & 730' E. FROM C 1/4 COR SEC. 34

FINAL PROOF SURVEY
UNDER

Application No. 5304.L. Permit No. 4002.9...
IN NAME OF

..... **WILLARD W. DERRICK**

Surveyed ...10-26... 1977., by **R. BARWIN**.....

RECEIVED
APR 2 1978
WATER RESOURCES DEPT
SALEM, OREGON